


15-065-00347-000

STATE OF KANSAS
STATE CORPORATION COMMISSION

Give All Information Completely
Make Required Affidavit
Mail or Deliver Report to:
Conservation Division
State Corporation Commission
800 Bittling Building
Wichita, Kansas

WELL PLUGGING RECORD

NORTH

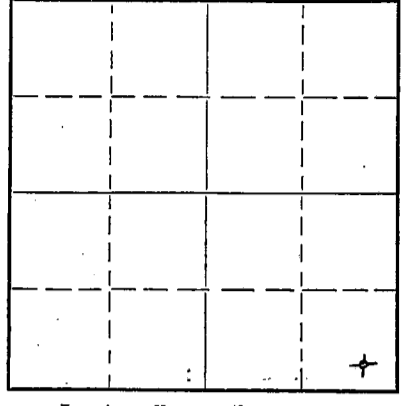

Locate well correctly on above
Section Plat

Graham County. Sec. 23 Twp. 10S Rge. 21 (E) W (W)
Location as "NE/CNW 1/4 SW 1/4" or footage from lines D SE/4 SE/4 SE/4
Lease Owner Anderson-Prichard Oil Corp.
Lease Name Barber Well No. 1
Office Address 1000 Apco Tower, Oklahoma City, Oklahoma
Character of Well (completed as Oil, Gas or Dry Hole) Dry Hole
Date well completed Jan. 10 19 52
Application for plugging filed Jan. 10 19 52
Application for plugging approved Jan. 10 19 52
Plugging commenced Jan. 10 19 52
Plugging completed Jan. 10 19 52
Reason for abandonment of well or producing formation Dry Hole

If a producing well is abandoned, date of last production 19
Was permission obtained from the Conservation Division or its agents before plugging was commenced? Yes

Name of Conservation Agent who supervised plugging of this well Eldon R. Petty
Producing formation Depth to top Bottom Total Depth of Well 3805 Feet
Show depth and thickness of all water, oil and gas formations.

OIL, GAS OR WATER RECORDS

CASING RECORD

Formation	Content	From	To	Size	Put In	Pulled Out
		0	220'	8 5/8"	220'	None

Describe in detail the manner in which the well was plugged, indicating where the mud fluid was placed and the method or methods used in introducing it into the hole. If cement or other plugs were used, state the character of same and depth placed, from feet to feet for each plug set.

3805' - 211 1/2' - Heavy Rotary Mud
211 1/2' - 210' - Wooden Plug
210' - 164' - 15 sacks cement & 1/2 sack hulls
164' - 41 1/2' - Heavy Rotary Mud
41 1/2' - 40' - Wooden Plug
40' - 6' - 10 sacks cement & 1/2 sack hulls
6' - Surface - C1 Cellar

RECEIVED
JAN 18 1952
CONS. DIV.
WICHITA, KANSAS


(If additional description is necessary, use BACK of this sheet)

Name of Plugging Contractor Glenn W. Peel
Address P. O. Box 359, Hoisington, Kansas

STATE OF Kansas, COUNTY OF Barton, ss.
Glenn W. Peel (employee of owner) or (owner/operator) of the above-described well,

being first duly sworn on oath, says: That I have knowledge of the facts, statements, and matters herein contained and the log of the above-described well as filed and that the same are true and correct. So help me God.

(Signature) BY: Glenn W. Peel
P. O. Box 359
HOISINGTON, KANSAS
(Address)

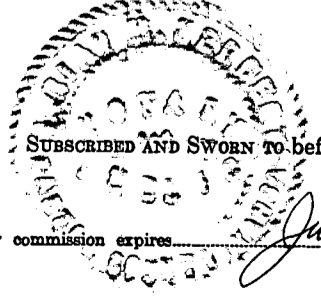

SUBSCRIBED AND SWORN to before me this 17th day of January, 19 52
Marian M. Hecker Notary Public.

BOOK PAGE 137 LINE 4

DRILLER'S LOG

Company: Anderson-Prichard Oil Corp.

SE/4 SE/4 SE/4
Sec. 23, Twp. 10S, Rge. 21W,

Farm: Barber Well No. 1
Total Depth: 3805'

County: Graham,
Kansas

Comm: 12-26-51 Comp: 1-10-52
Contractor: Glenn W. Peel
Casing: 8 5/8" 220' cem.

Elevation:
Production: Dry

Figures below indicate bottom of formations

Surface Soil & Water Sands	0 -	90
Sand & Shale		160
Shale		650
Sand & Shale		1490
Shale & Shells		1585
Red Bed & Shells		1625
Anhydrite		1635
Shale & Shells		1950
Sand & Shale		2147
Lime & Shale		2400
Sand & Shale		2530
Shale & Lime		3346
Lime & Shale		3467
Lime		3490
Lime & Shale		3540
Lime		3572
Lime & Shale		3635
Lime		3705
Lime & Conglomerate		3752
Arbuckle		3805
Total Depth		3805

This is to certify that the above information is, to the best of our knowledge true and correct.

STATE COMMISSION

GLENN W. PEEL

JAN 18 1952

CONSERVATION DIVISION
Wichita, Kansas

BY: [Signature]

SUBSCRIBED AND SWORN to before me this 17th day of January, 1952.

My commission expires June 4, 1955

[Signature]
Notary Public

PLUGGING
FILE SEC 23 T 10 R 21W
BOOK PAGE 37 LINE 4