

CARD MUST BE TYPED

State of Kansas
NOTICE OF INTENTION TO DRILL

CARD MUST BE SIGNED

(see rules on reverse side)

Starting Date: 3 7 85
month day year

API Number 15-

de ac
163-22,629-00-00

OPERATOR: License # 8925

Name Liberty Operations & Completions, Inc.

Address 308 West Mill

City/State/Zip Plainville, KS 67663

Contact Person David L. Comeau

Phone (913) 434-4686

CONTRACTOR: License # 5665

Name Pioneer Drilling Company, Inc.

City/State Plainville, Kansas

Well Drilled For: Well Class: Type Equipment:

- Oil Swd Infield Mud Rotary
- Gas Inj Pool Ext. Air Rotary
- OWWO Expl Wildcat Cable

If OWWO: old well info as follows:

Operator

Well Name

Comp Date Old Total Depth

Projected Total Depth 3500 feet

Projected Formation at TD Arbuckle

Expected Producing Formations Arbuckle

NE NE SE Sec 19 Twp 10 S, Rge 18 East West

(location)
2310 Ft North from Southeast Corner of Section
330 Ft West from Southeast Corner of Section
(Note: Locate well on Section Plat on reverse side)

Nearest lease or unit boundary line 330 feet.

County Rooks

Lease Name Wise Well# 4

Domestic well within 330 feet : yes no

Municipal well within one mile : yes no

Depth to Bottom of fresh water 100 feet

Lowest usable water formation Dakota

Depth to Bottom of usable water 900 feet

Surface pipe by Alternate : 1 2

Surface pipe to be set 238 feet

Conductor pipe if any required N/A feet

Ground surface elevation feet MSL

This Authorization Expires 8-6-85

Approved By *2-6-85* *E*

I certify that we will comply with K.S.A. 55-101, et seq., plus eventually plugging hole to K.C.C. specifications.

Date *2-4-85* Signature of Operator or Agent


[Signature] Title *Unit Pres.*

MHC/KOHE 2-6-85

Must be filed with the K.C.C. five (5) days prior to commencing well
This card void if drilling not started within six (6) months of date received by K.C.C.

Important procedures to follow :

**A Regular Section of Land
1 Mile = 5,280 Ft.**

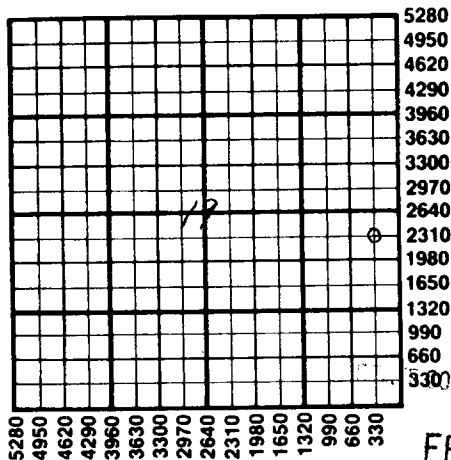

1. Notify District office before setting surface casing.
2. Set surface casing by circulating cement to the top.
3. File completion forms ACO-1 with K.C.C. within 90 days of well completion, following instructions on ACO-1, side 1, and including copies of wireline logs.
4. Notify District office 48 hours prior to old well workover or re-entry.
5. Prior to plugging, prepare a plugging plan, then obtain agreement from the appropriate district office for an approved plugging plan.
6. Submit plugging report (CP-4) to K.C.C. after plugging is completed.
7. Obtain an approved injection docket number before disposing of salt water.
8. Notify K.C.C. within 10 days when injection commences or terminates.
9. If an alternate 2 completion, cement in the production pipe from below any usable water to surface within 120 days of spud date.

FEB 06 1995

CONSERVATION DIVISION
Wichita, Kansas

State Corporation Commission of Kansas
Conservation Division
200 Colorado Derby Building
Wichita, Kansas 67202
(316) 263-3238