

CARD MUST BE TYPED

State of Kansas NOTICE OF INTENTION TO DRILL

CARD MUST BE SIGNED

(see rules on reverse side)

Starting Date: November 7, 1985
month day year

API Number 15- 163-22,808 ⁰⁰ ⁰⁰
SW NW NW Sec 18 Twp 10 S, Rge 18 East West
(location)

OPERATOR: License # 5418
Name Allen Drilling Company
Address P.O. Box 1389
City/State/Zip Great Bend, KS 67530
Contact Person Doug Hoisington
Phone 316 - 793-5877

4290 Ft North from Southeast Corner of Section
4950 Ft West from Southeast Corner of Section
(Note: Locate well on Section Plat on reverse side)

CONTRACTOR: License # 5418
Name Allen Drilling Company
City/State Great Bend, KS

Nearest lease or unit boundary line 330 feet.
County Rooks
Lease Name VOHS Well# 1-18

Well Drilled For: Well Class: Type Equipment:
 Oil Swd Infield Mud Rotary
 Gas Inj Pool Ext. Air Rotary
 OWWO Expl Wildcat Cable

Domestic well within 330 feet: yes no
Municipal well within one mile: yes no

If OWWO: old well info as follows:

Operator N/A
Well Name
Comp Date Old Total Depth
Projected Total Depth 3800 feet
Projected Formation at TD Arbuckle
Expected Producing Formations LKC, Arbuckle

Depth to Bottom of fresh water 150 feet
Lowest usable water formation Dakota
Depth to Bottom of usable water 950 feet
Surface pipe by Alternate: 1 2
Surface pipe to be set 250 feet
Conductor pipe if any required N/A feet
Ground surface elevation N/A feet MSI
This Authorization Expires 5-2-86

I certify that we will comply with K.S.A. 55-101, et seq., plus eventually plugging hole to K.C.C. specifications.


Date 10/31/85 Signature of Operator or Agent *Jeanne P. Ross* Title Geologist

RCA/KOHE

**Must be filed with the K.C.C. five (5) days prior to commencing well
This card void if drilling not started within six (6) months of date received by K.C.C.**

Important procedures to follow :

**A Regular Section of Land
1 Mile = 5,280 Ft.**

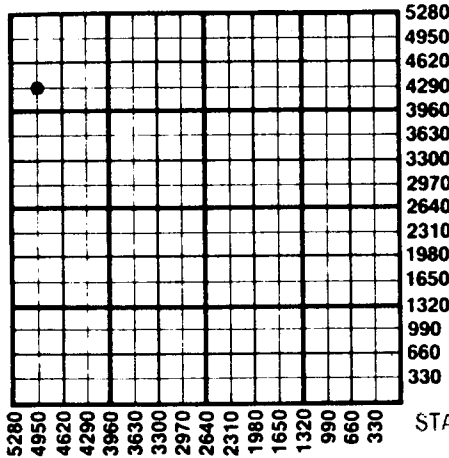

1. Notify District office before setting surface casing.
2. Set surface casing by circulating cement to the top.
3. File completion forms ACO-1 with K.C.C. within 90 days of well completion, following instructions on ACO-1, side 1, and including copies of wireline logs.
4. Notify District office 48 hours prior to old well workover or re-entry.
5. Prior to plugging, prepare a plugging plan, then obtain agreement from the appropriate district office for an approved plugging plan.
6. Submit plugging report (CP-4) to K.C.C. after plugging is completed.
7. Obtain an approved injection docket number before disposing of salt water.
8. Notify K.C.C. within 10 days when injection commences or terminates.
9. If an alternate 2 completion, cement in the production pipe from below any usable water to surface within 120 days of spud date.

RECEIVED

STATE CORPORATION COMMISSION

**State Corporation Commission of Kansas
Conservation Division
200 Colorado Derby Building
Wichita, Kansas 67202
(316) 263-3238**

NOV 4 1955

CONSERVATION DIVISION
Wichita, Kansas