

State Corporation Commission
 Wichita State Office Bldg.
 130 S. Market, Room 2078
 Wichita, Kansas 67202

WELL PLUGGING RECORD
 K.A.R.-82-3-117

15-065-19261-00-01

API NUMBER _____

LEASE NAME McClellan

WELL NUMBER 6

1650 Ft. from S Section Line

330 Ft. from E Section Line

SEC. 02 TWP. 10 RGE. 21 (E) or (W)

COUNTY Graham

Date Well Completed _____

Plugging Commenced 7/5/94

Plugging Completed 7/4/94

TYPE OR PRINT
NOTICE: Fill out completely
and return to Cons. Div.
office within 30 days.

LEASE OPERATOR PRODUCTION DRILLING INC

ADDRESS PO BOX 680

PHONE (913) 625-1189 OPERATORS LICENSE NO. 5386

Character of Well _____

(Oil, Gas, O&A, SWD, Input, Water Supply Well)

The plugging proposal was approved on July 5, 1994 (date)

by Herb Deines (KCC District Agent's Name).

Is ACO-1 filed? _____ If not, is well log attached? no logs run

Producing Formation Lower Arb Depth to Top 3800 Bottom 4260 T.O. 4200

Show depth and thickness of all water, oil and gas formations.

OIL, GAS OR WATER RECORDS | **CASING RECORD**

Formation	Content	From	To	Size	Put In	Pulled out
		0	175	8 5/8		-0-
		surface	3825	5 1/2		-0-

Describe in detail the manner in which the well was plugged, indicating where the mud fluid was placed and the method or methods used in introducing it into the hole. If cement or other plug were used, state the character of same and depth placed, - from _____ feet to _____ feet each set
PUMP 275 SKS CEMENT AT SURFACE

Name of Plugging Contractor Allied License No. _____

Address PO BOX 31, RUSSELL KS 67665

NAME OF PARTY RESPONSIBLE FOR PLUGGING FEES: Production Drilling, Inc

STATE OF KS COUNTY OF ELLIS, ss.

Larry L. Patterson (Employee of Operator) or (Operator) of

above-described well, being first duly sworn on oath, says: That I have knowledge of the facts stated, and matters herein contained and the log of the above-described well as filed and the same are true and correct, so help me God.

(Signature) [Signature]

(Address) PO BOX 680 Hays KS 67601

SUBSCRIBED AND SWORN TO before me this 10 day of October, 19 94

[Signature]
 Notary Public

My Commission Expires: 8/31/97

USE ONLY ONE SIDE OF EACH FORM




RECEIVED
 STATE CORPORATION COMMISSION
 OCT 12 1994
 10-12-1994
 CONSERVATION DIVISION
 WICHITA, KANSAS

KCC LEASE SURVEY PLAT



LEASE McClellan #6, COUNTY Graham

Section 02, Township 10, Range 21W

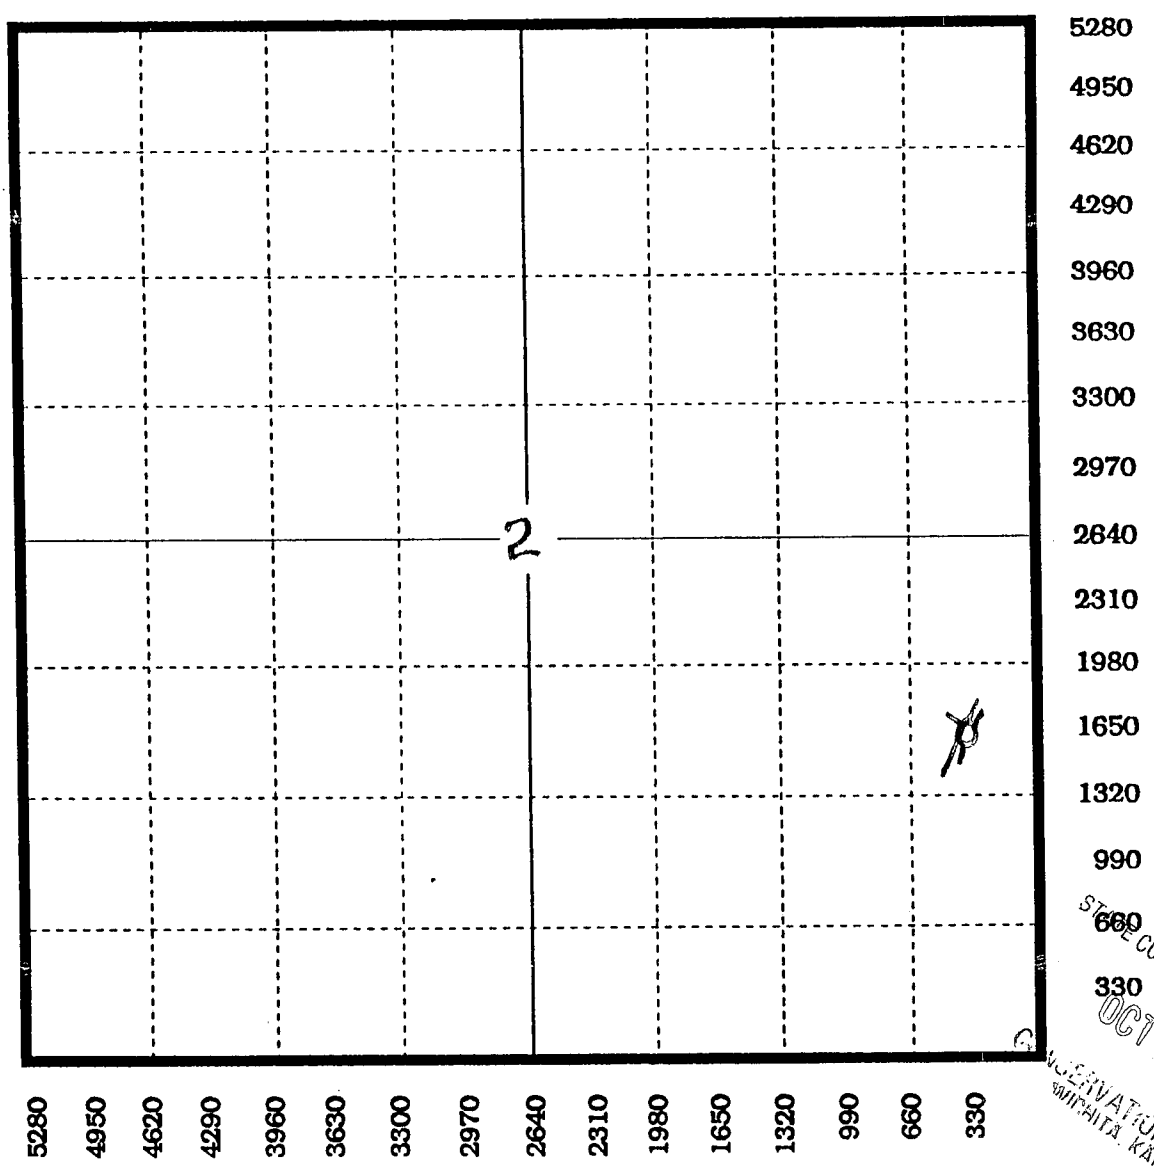

RECEIVED
STATE CORPORATION COMMISSION
OCT 12 1994
CONSERVATION DIVISION
WICHITA, KANSAS

Company Production Drilling Inc
 Address PO Box 680
 City/State Hays KS
 Phone 913-625-1189 Lic # 5386
 KCC Agent _____ Date _____

- Dry Hole
- Oil Well
- Plugged Oil Well
- Plugged SWD
- Gas Well
- Temporary Abandoned
- Abandoned
- Injection Well
- SWD
- Plugged Injection Well
- Water Supply Well

RECEIVED
STATE CORPORATION COMMISSION
OCT 01 1994