

STATE OF KANSAS  
STATE CORPORATION COMMISSION


WELL PLUGGING RECORD

OR  
FORMATION PLUGGING RECORD

Strike out upper line when reporting plugging of formations.

Give All Information Completely  
Make Required Affidavit  
Mail or Deliver Report to:  
Conservation Division  
State Corporation Commission  
800 Bitting Building  
Wichita, Kansas

Graham County. Sec. 5 Twp. 10S Rge. (E) 21 (W)  
Location as "NE 1/4 NW 1/4 SW 1/4" or footage from lines. C SE SE SE  
Lease Owner W. L. Hartman, et al.  
Lease Name Towns Well No. 1  
Office Address Box 54, Wichita, Kansas  
Character of Well (completed as Oil, Gas or Dry Hole) Dry Hole  
Date well completed July 18, 1945 19  
Application for plugging filed July 18, 1945 19  
Application for plugging approved July 18, 1945 19  
Plugging commenced July 18, 1945 19  
Plugging completed July 18, 1945 19  
Reason for abandonment of well or producing formation Dry Hole

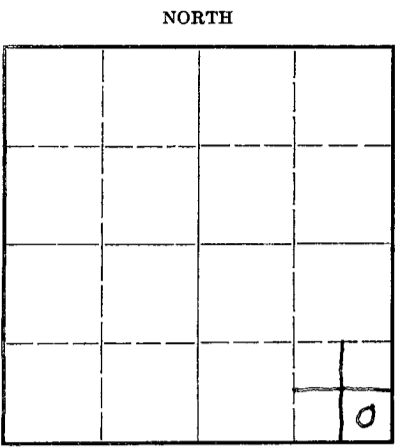

Locate well correctly on above Section Plat

If a producing well is abandoned, date of last production --- 19  
Was permission obtained from the Conservation Division or its agents before plugging was commenced? yes

Name of Conservation Agent who supervised plugging of this well H. W. Kerr  
Producing formation none Depth to top --- Bottom --- Total Depth of Well 3928 Feet  
Show depth and thickness of all water, oil and gas formations.

OIL, GAS OR WATER RECORDS CASING RECORD

Formation	Content	From	To	Size	Put In	Pulled Out
Surface Pipe		0	215	8 5/8	215'	none

Describe in detail the manner in which the well was plugged, indicating where the mud fluid was placed and the method or methods used in introducing it into the hold. If cement or other plugs were used, state the character of same and depth placed, from --- feet to --- feet for each plug set.

Hole was mudded back to 215', set bridge, cemented with 16 sacks. Hole was mudded back to within 15' of the top, set bridge, cut surface pipe off at base of cellar, cemented 10 sacks and cement returned to base of cellar covering surface pipe at point where it had been cut.

PLUGGING  
FILE 5 10-21W  
DOC 21 SE 9

7-25-1945

(If additional description is necessary, use BACK of this sheet)

Correspondence regarding this well should be addressed to W. L. Hartman  
Address Box 54, Wichita, Kansas

STATE OF Kansas, COUNTY OF Barton, ss.  
I, G. W. Reyes, Drilling Contractor (employee of owner) or (owner or operator) of the above-described well, being first duly sworn on oath, says: That I have knowledge of the facts, statements, and matters herein contained and the log of the above-described well as filed and that the same are true and correct. So help me God.

(Signature) G. W. Reyes  
Ellinwood, Kansas (Address)

SUBSCRIBED AND SWORN TO before me this 20th day of July, 19 45  
My commission expires July 7, 1948  
Notary Public.

WELL LOG

W. L. Hartman, etal., Owners - Towns #1

Center SE SE SE Section 5, Township 10 S, Range 21 W,  
Graham County, Kansas

Figures indicate bottom of formation

	0	to	60	Clay and shells
			180	Shale
			215	Shells and shale
			675	Gray and blue shale and shells
			740	Shale
			975	Sand
Elevation	2277		1260	Shale and shells
			1565	Sand and shale
Pipe:			1760	Shale and shells
8 5/8" OD 28# 8 V Thread			1775	Iron, sand and red bed
set at 215'			1805	Anhydrite
			1865	Lime
			2270	Shale and shells
			2355	Lime
Top Lansing	3539		2520	Shale and shells
Top Marmaton	3832		2635	Lime
Top Conglomerate	3846		2725	Shale and shells
Top Arbuckle	3878		2795	Shale
			2810	Sand
			2905	Lime and shale
			2980	Broken lime
			3025	Lime
			3105	Broken lime
			3165	Lime
			3250	Lime and shale
			3410	Lime
			3420	Shale
			3539	Lime
			3832	Lime
			3846	Marmaton chert
Started June 30, 1945			3878	Conglomerate
Abandoned Dry July 18, 1945			3928	Lime
			3928	Total Depth, still in Arbuckle

DRILLING  
 FILE 5 10-R2160  
 BOOK 21 ME-9

7-25-1945  
 25

State of Kansas )  
County of Barton) ss

I, G. W. Keyes, Drilling Contractor of the above-described well, being first duly sworn on oath, declare: That I have knowledge of the facts, statements and matters herein contained pertaining to the log of the above-described well as filed and that the same are true and correct.

G. W. Keyes

Subscribed and Sworn to before me this 19th day of July, 1945.

My commission expires July 7, 1948.

J. J. Rader