


STATE OF KANSAS
STATE CORPORATION COMMISSION

WELL PLUGGING RECORD

Give All Information Completely
Make Required Affidavit
Mail or Deliver Report to
Conservation Division
State Corporation Comm.
245 North Water
Wichita, KS 67202

Graham County, Sec. 5 Twp. 10S Rge. 21 E/W
Location as "NE/CNW $\frac{1}{4}$ /SW $\frac{1}{4}$ " or footage from lines _____
NW NW SW

Lease Owner Den Can O&G
Lease Name Cooley Well No. 1
Office Address 105 N. Market Wichita, Kansas 67202
Character of Well (Completed as Oil, Gas or Dry Hole) _____

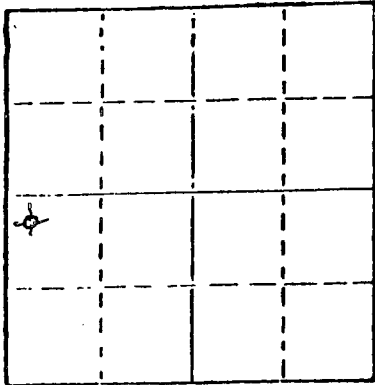

Locate well correctly on above
Section Plat

Dry Hole
Date Well completed 8-10 1981
Application for plugging filed 8-10 1981
Application for plugging approved 8-10 1981
Plugging commenced 8-10 1981
Plugging completed 8-10 1981
Reason for abandonment of well or producing formation _____

Dry Hole
If a producing well is abandoned, date of last production _____
19 _____

Was permission obtained from the Conservation Division or
its agents before plugging was commenced? Yes

Name of Conservation Agent who supervised plugging of this well Gilbert Balthazor
Producing formation _____ Depth to top _____ Bottom _____ Total Depth of Well 3941'
Show depth and thickness of all water, oil and gas formations.

OIL, GAS OR WATER RECORDS

CASING RECORD

FORMATION	CONTENT	FROM	TO	SIZE	PUT IN	PULLED OUT
Surface		0	241'	8 5/8"	241'	0

Describe in detail the manner in which the well was plugged, indicating where the mud fluid
was placed and the method or methods used in introducing it into the hold. If cement or other
plugs were used, state the character of same and depth placed, from _____ feet to
_____ feet for each plug set.

1st. Plug set at 900' with 60 sacks common cement 50-50poz 6% Gel

2nd. Plug set at 240' with 40 sacks common cement 50-50 poz 6% Gel

3rd. Plug set at 40' with 10 sacks common cement 6% Gel

5 sacks in rathole

RECEIVED

8-14-1981

AUG 14 1981

Circulated drill mud

CONSERVATION DIVISION

(If additional description is necessary, use BACK of _____ sheet)

Name of Plugging Contractor Allied Cementing

STATE OF Kansas COUNTY OF Graham, ss.
Jerry M. Helberg (employee of owner) or (owner or operator)
of the above-described well, being first duly sworn on oath, says: That I have knowledge of
the facts, statements, and matters herein contained and the log of the above-described well
as filed and that the same are true and correct. So help me God.

(Signature)

Jerry M. Helberg
Morland, Kansas 67650
(Address)

SUBSCRIBED AND SWORN TO before me this 13 day of August, 1981

Janice Beckman
Notary Public.

My commission expires 12-4-83



DRILLERS LOG

COOLEY #1

CASING RECORD:

8 5/8" set at 241'

TOTAL DDPH:

3941'

DESCRIPTION:

NW NW SW
Sec. 5, Twp. 10S, Rge. 21W

OPERATOR: Den Can O&G

CONTRACTOR: Helberg Oil Company

COMMENCED: July 30, 1981

COMPLETED: August 8, 1981

FORMATION	TO	FROM	REMARKS
Sand	0	260	
Sand	260	1192	
Sand & Shale	1192	1810	
Shale	1810	2090	
Anhydrite	1811	1855	
Shale	2090	2375	
Shale	2375	2518	
Shale	2518	2632	
Shale & Lime	2632	2732	
Shale & Lime	2732	2929	
Shale & Lime	2929	2997	
Shale	2997	3160	
Shale & Lime	3160	3300	
Shale & Lime	3300	3417	
Shale & Lime	3417	3500	
Shale & Lime	3500	3580	
Shale & Lime	3580	3655	
Lime	3655	3672	
Lime	3672	3722	
Lime	3722	3765	
Lime	3765	3815	
Lime	3815	3850	
Shale & Lime	3850	3899	
Lime	3899	3939	
T.D.	3941'		D&A

I certify that the above is a true and correct copy of the log to the best of my knowledge.

Helberg Oil Company

Jerry M. Helberg
Jerry M. Helberg

Subscribed and sworn to before me this 13 day of August, 1981.

Janice Reckman
Notary Public

My commission expires 12 1981

RECEIVED
STATE CORPORATION COMMISSION

8-14-1981
AUG 14 1981

CONSERVATION DIVISION
Wichita, Kansas

