


STATE OF KANSAS
STATE CORPORATION COMMISSION

WELL PLUGGING RECORD

Give All Information Completely
Make Required Affidavit
Mail or Deliver Report to:
Conservation Division
State Corporation Commission
800 Bittling Building
Wichita, Kansas

NORTH

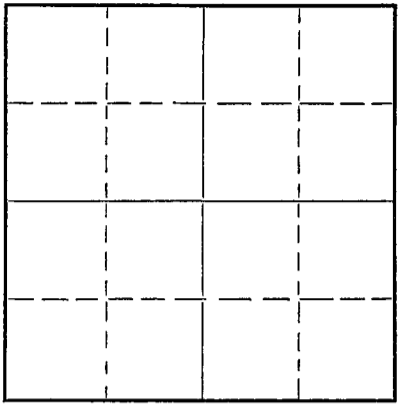

Locate well correctly on above
Section Plat

Graham County, Sec. 2 Twp 10 Rge. ~~21~~ 21 (W)
Location as "NE/CNW $\frac{1}{4}$ SW $\frac{1}{4}$ " or footage from lines NW $\frac{1}{4}$
Lease Owner Phillips Petroleum Company
Lease Name Noah Well No. 7
Office Address Box 779 - Great Bend, Kansas
Character of Well (completed as Oil, Gas or Dry Hole) Dry Hole
Date well completed January 9, 1952
Application for plugging filed January 10, 1952
Application for plugging approved 19
Plugging commenced January 10, 1952
Plugging completed January 10, 1952
Reason for abandonment of well or producing formation Dry Hole

If a producing well is abandoned, date of last production 19
Was permission obtained from the Conservation Division or its agents before plugging was commenced? Yes

Name of Conservation Agent who supervised plugging of this well Mr. Eldon Petty
Producing formation Arbuckle Depth to top 4030 Bottom 4065 Total Depth of Well 4065 Feet
Show depth and thickness of all water, oil and gas formations.

OIL, GAS OR WATER RECORDS

CASING RECORD

Formation	Content	From	To	Size	Put In	Pulled Out
Arbuckle	Dry	4030	4065	8-5/8"	315.04'	None

Describe in detail the manner in which the well was plugged, indicating where the mud fluid was placed and the method or methods used in introducing it into the hole. If cement or other plugs were used, state the character of same and depth placed, from feet to feet for each plug set.

Filled hole with heavy rotary mud - pushed Howco wood plug to 319' - gravel 319' to 300'. Dumped 25 sx. cement 300' to 225'. Mudded to 40' - pushed Howco plug to 40' - 10 sx. cement 40' to base of cellar. Well plugged and abandoned 9:00 P.M. 1-10-52

1-15-1952

(If additional description is necessary, use BACK of this sheet)

Correspondence regarding this well should be addressed to A. J. Willis
Address Box 779 - Great Bend, Kansas

STATE OF Kansas, COUNTY OF Barton, ss.
A. J. Willis (employee of owner) ~~is owner or operator~~ of the above-described well,

being first duly sworn on oath, says: That I have knowledge of the facts, statements, and matters herein contained and the log of the above-described well as filed and that the same are true and correct. So help me God.

(Signature) *A. J. Willis*
Box 779 - Great Bend, Kansas
(Address)

SUBSCRIBED AND SWORN to before me this 11th day of January, 1952

Joseph M. Beal
Notary Public.

My commission expires November 18, 1953

2 10 21
27 4

Formation Record

Lease Noah

Well No. 7

FROM	TO	Formation	REMARKS
0	60	Surface clay.	
60	1430	Sand and shale.	
1430	1777	Sand, shale, Red Bed and Anhydrite.	
1777	2013	Red Bed and Anhydrite.	
2013	2203	Lime and shale.	
2203	2382	Shale and shells.	
2382	2669	Lime and shale.	
2669	2854	Lime, shale and chalk.	
2854	2999	Lime and shale.	
2999	3172	Lime, shale and chalk.	
3172	3975	Lime and shale.	
3975	4065	Lime.	Top Arbuckle 4030'.

Top Arbuckle 4030'.

1-15-1952
JAN 15 1952

FILED 2 10 202
BOOK 137 4