

15-065-02527-0000

STATE OF KANSAS
STATE CORPORATION COMMISSION


WELL PLUGGING RECORD

Give All Information Completely
Make Required Affidavit
Mail or Deliver Report to:
Conservation Division
State Corporation Commission
800 Biting Building
Wichita, Kansas

Graham County. Sec. 35 Twp. 10 Rge. 21 (E) W (W)

Location as "NE/CNW%SW%" or footage from lines C/N/2 NE NW
Lease Owner Stanolind Oil and Gas Company
Lease Name S. S. Zeigler Well No. 2
Office Address Box 1654, Oklahoma City, Oklahoma
Character of Well (completed as Oil, Gas or Dry Hole) Dry Hole
Date well completed February 5 19 54
Application for plugging filed February 5 19 54
Application for plugging approved February 5 19 54
Plugging commenced February 5 19 54
Plugging completed February 5 19 54
Reason for abandonment of well or producing formation Dry Hole

NORTH

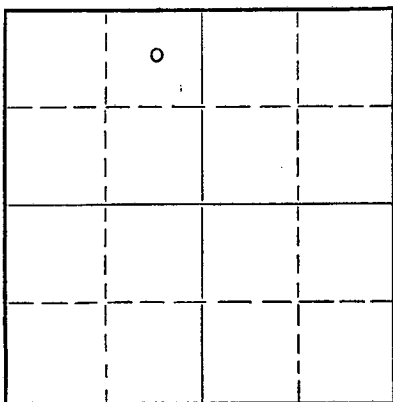

Locate well correctly on above
Section Plat

If a producing well is abandoned, date of last production 19
Was permission obtained from the Conservation Division or its agents before plugging was commenced? Yes

Name of Conservation Agent who supervised plugging of this well Eldon Petty
Producing formation None Depth to top _____ Bottom _____ Total Depth of Well 3750 Feet
Show depth and thickness of all water, oil and gas formations.

OIL, GAS OR WATER RECORDS

CASING RECORD

FORMATION	CONTENT	FROM	TO	SIZE	PUT IN	PULLED OUT
Lansing		3366		8-5/8	217	0
Arbuckle		3716				

Describe in detail the manner in which the well was plugged, indicating where the mud fluid was placed and the method or methods used in introducing it into the hole. If cement or other plugs were used, state the character of same and depth placed, from _____ feet to _____ feet for each plug set.

Heavy mud from 3750 to 200', run plug, 1/2 sack hulls, 155 sacks cement to 40;

Run plug, 1/2 sack hulls, 105 sacks of cement to bottom of cellar.

(If additional description is necessary, use BACK of this sheet)

Name of Plugging Contractor Prime Drilling Company
Address 1005 Central Building, Wichita, Kansas

STATE OF Kansas, COUNTY OF Russell, ss.
Ralph Ludwick (employee of owner) or (owner or operator) of the above-described well, being first duly sworn on oath, says: That I have knowledge of the facts, statements, and matters herein contained and the log of the above-described well as filed and that the same are true and correct. So help me God.

(Signature) Ralph Ludwick
Box 35, Gorham, Kansas
(Address)

SUBSCRIBED AND SWORN TO before me this 22nd day of February, 19 54

My commission expires May 18, 1955.

M.F. Mainard
Notary Public.

24-7368-S

3-53-20M

PLUGGING
FILE SEC 35 T 10 R 21 W
BOOK PAGE 12 LINE 23

RECEIVED
STATE CORP COM
02-24-54
FEB 24 1954

FORMATION RECORD

DESCRIBE EACH FORMATION DRILLED. INDICATE THICKNESS, CONTENT AND WHETHER DRY, OR OIL, GAS, OR WATER BEARING.

FORMATION	TOP	BOTTOM	FORMATION	TOP	BOTTOM
Surface Rock & Clay	0	30			
Sand	30	50			
Shale	50	70			
Shale & Shells	70	222			
Shale	222	316			
Shale & Shells	316	780			
Sand & Shale	780	885			
Shale & Shells	885	1080			
Sand	1080	1295			
Shale, Red Bed & Shells	1295	1340			
Red Bed & Shale	1340	1587			
Anhydrite	1587	1635			
Shale & Shell	1635	2065			
Shale & Lime	2065	2190			
Lime & Shale	2190	2270			
Shale & Lime	2270	2870			
Lime & Shale	2870	2950			
Shale & Lime	2950	3180			
Lime & Shale	3180	3340			
Lime	3340	3635			
Lime & Shale	3635	3695			
Shale & Lime	3695	3750			
Total Depth		<u>3750</u>			
Date First Work:	1-28-51				
Date Spudded:	1-23-51				
Date Completed:	2-5-51				
Plugged & Abandoned:	2-5-51				

PLUGGING
 BY 35 T 10 R 21W
 DATE 12/23