


OR
FORMATION PLUGGING RECORD

Strike out upper line
when reporting plug-
ging off formations.

Give All Information Completely
Make Required Affidavit
Mail or Deliver Report to:
Conservation Division
State Corporation Commission
800 Bitting Building
Wichita, Kansas

Hooks County. Sec. 24 Twp. 10S Rge. (E) 20W (W)
Location as "NE $\frac{1}{4}$ NW $\frac{1}{4}$ SW $\frac{1}{4}$ " or footage from lines SW $\frac{1}{2}$ SE $\frac{1}{2}$ SE $\frac{1}{2}$
Lease Owner Birmingham-Bartlett Drilling Co., et al
Lease Name Sutor "B" Well No. 1
Office Address 300 Kaufman Building, Wichita 2, Kansas
Character of Well (completed as Oil, Gas or Dry Hole) Dry Hole
Date well completed March 30 19 50
Application for plugging filed (verbal approval granted) April 3 19 50
Application for plugging approved March 30 19 50
Plugging commenced March 30 19 50
Plugging completed March 30 19 50
Reason for abandonment of well or producing formation Dry hole

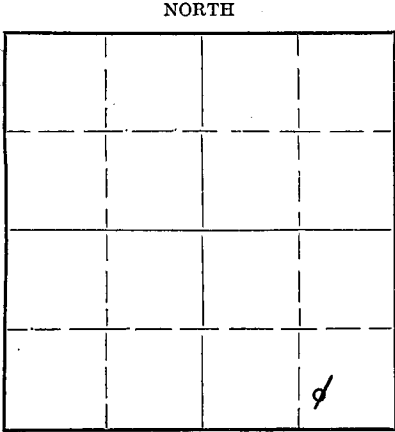

Locate well correctly on above
Section Plat

If a producing well is abandoned, date of last production _____ 19____
Was permission obtained from the Conservation Division or its agents before plugging was com-
menced? Yes
Name of Conservation Agent who supervised plugging of this well Eldon Petty
Producing formation Arbuckle Depth to top 3744 Bottom 3748 Total Depth of Well 3748 Feet
Show depth and thickness of all water, oil and gas formations.

OIL, GAS OR WATER RECORDS

CASING RECORD

Formation	Content	From	To	Size	Put In	Pulled Out
				8-5/8"	198'	None

Describe in detail the manner in which the well was plugged, indicating where the mud fluid was placed and the method or methods used in introducing it into the hole. If cement or other plugs were used, state the character of same and depth placed, from _____ feet to _____ feet for each plug set.

Filled hole with heavy mud. 15 sacks cement on bottom plug @ 190'; 10 sacks on top plug, below cellar.

04-04-50

(If additional description is necessary, use BACK of this sheet)

Correspondence regarding this well should be addressed to Birmingham-Bartlett Drilling Co.
Address 300 Kaufman Building, Wichita, Kansas

STATE OF KANSAS, COUNTY OF SEDGWICK, ss.

Richard Hindery, partner of operator of the above-described well, being first duly sworn on oath, says: That I have knowledge of the facts, statements, and matters herein contained and the log of the above-described well as filed and that the same are true and correct. So help me God.

(Signature)

Richard Hindery


300 Kaufman Building, Wichita 2, Kansas
(Address)

SUBSCRIBED AND SWORN to before me this 3rd day of April 19 50

Vincent J. Ginger

Notary Public.

My commission expires November 29, 1950

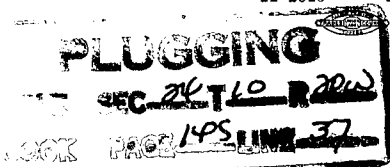

SUTOR "B" #1

LOCATION:	SW 3/4 Sec. 24-103-20W Rocks County, Kansas	SPUDDED:	3-18-50
OPERATOR:	Birmingham-Bartlett Drilling Co.	COMPLETED:	3-30-50
CONTRACTOR:	Birmingham-Bartlett Drilling Co.		
SURFACE CASING:	8-5/8" casing cemented 138' w/150 sacks cement & 2 c.c.		
OILSTRING:	None - D & A		

LOG

(Figures indicate bottom of formation)

0 to	140	Sand & Shale
	198	Shale & Shells
	735	Shale
	845	Sand
	1040	Shale & Sand
	1250	Sand
	1550	Shale
	1592	Anhydrite
	2165	Shale & Shells
	2710	Shale & Lime
	3135	Shale
	3210	Lime & Shale
	3280	Lime
	3410	Shale & Lime
	3645	Lime
	3680	Conglomerate
	3720	Cherty Conglomerate
	3743	Conglomerate
	3748	Arbuckle Lime
	3748	Total Depth

The undersigned Richard Hindery of the BIRMINGHAM-BARTLETT DRILLING CO. hereby certifies that the above is a true and correct log of the formations encountered in drilling the Sutor "B" #1 as shown on the daily drilling reports.

BIRMINGHAM-BARTLETT DRILLING CO.

BY Richard Hindery

Subscribed and sworn before me
this 3rd day of April, 1950.

Vivian Z. Finger
Notary Public

My commission expires: November 29, 1950.

