

15-163-00609-0000

STATE OF KANSAS
STATE CORPORATION COMMISSION

WELL PLUGGING RECORD

Give All Information Completely
Make Required Affidavit
Mail or Deliver Report to:
Conservation Division
State Corporation Commission
800 Bitting Building
Wichita, Kansas

Rooks County. Sec. 24 Twp. 10S Rge. (E) 20 (W)

Location as "NE/CNW/SW" or footage from lines NW NW SW

Lease Owner Jones, Shelburne & Farmer, Inc.

Lease Name Sutor C Well No. 1

Office Address Russell, Kansas

Character of Well (completed as Oil, Gas or Dry Hole) Dry

Date well completed 8-7 19.52

Application for plugging filed 8-7 19.52

Application for plugging approved 8-7 19.52


Plugging commenced 8-7 19.52

Plugging completed 8-7 19.52

Reason for abandonment of well or producing formation Dry

If a producing well is abandoned, date of last production Never Produced 19

Was permission obtained from the Conservation Division or its agents before plugging was commenced? yes

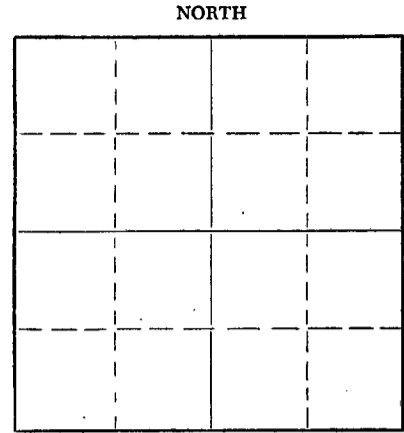

Locate well correctly on above Section Plat

Name of Conservation Agent who supervised plugging of this well Elden Petty

Producing formation Depth to top Bottom Total Depth of Well 3780 Feet

Show depth and thickness of all water, oil and gas formations.

OIL, GAS OR WATER RECORDS

CASING RECORD

FORMATION	CONTENT	FROM	TO	SIZE	PUT IN	PULLED OUT
				8 5/8	165	None

Describe in detail the manner in which the well was plugged, indicating where the mud fluid was placed and the method or methods used in introducing it into the hole. If cement or other plugs were used, state the character of same and depth placed, from _____ feet to _____ feet for each plug set.

1. Filled hole with heavy mud to 160'
2. Pushed Halliburton plug to 160'
3. Dumped in 1/2 sack of hulls on top of plug
4. Mixed and dumped 15 sacks of cement on top of hulls.
5. Filled hole to 40'
6. Pushed second Halliburton plug to 40'
7. Dumped 1/2 sack of hulls on top of plug
8. Mixed 10 sacks of cement and filled hole with same.

AUG 14 1952 08-14-52

CONSERVATION DIVISION
(If additional description is necessary, use BACK of this sheet)


Name of Plugging Contractor Jones, Shelburne & Farmer, Inc.
Address Russell, Kansas

STATE OF _____, COUNTY OF _____, ss. _____ (employee of owner) or (owner or operator) of the above-described well, being first duly sworn on oath, says: That I have knowledge of the facts, statements, and matters herein contained and the log of the above-described well as filed and that the same are true and correct. So help me God.

(Signature) John W. Farmer

(Address) _____

SUBSCRIBED AND SWORN to before me this 13th day of August, 1952
Bonnie Berryhill
Notary Public.

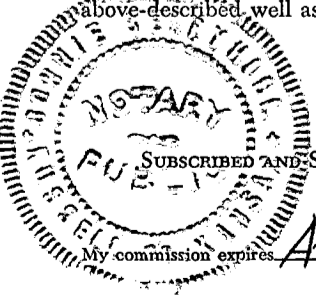


PLUGGING
FILE SEC 24 T 10 R 20
BOOK PAGE 37 LINE 3

OPERATOR Jones, Shelburne & Farmer, Inc.

FORMATION RECORD

ADDRESS Russell, Kansas

Give detailed description and thickness of all formations drilled through, contents of sand, whether dry, water, oil or gas.

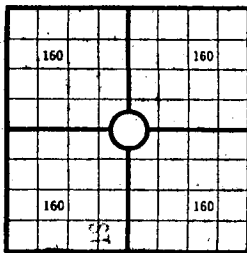640 Acres
N

Locate well correctly

COUNTY Rooks, SEC. 24, TWP. 10S, RGE. 20W

COMPANY OPERATING Jones, Shelburne & Farmer, Inc.

OFFICE ADDRESS Russell, Kansas

FARM NAME Sutor C WELL NO. 1

DRILLING STARTED 7-22, 1952 DRILLING FINISHED 8-7, 52

DATE OF FIRST PRODUCTION COMPLETED

WELL LOCATED NW 1/4 NW 1/4 SW 1/4, North of South

Line and _____ ft. East of West Line of Quarter Section

Elevation (Relative to sea level) DERRICK FLOOR 2180 FEET

CHARACTER OF WELL (Oil, gas or dryhole) Dry

OIL OR GAS SANDS OR ZONES

From	To	Name	From	To
		4		
		5		
		6		

Perforating Record If Any

Shot Record

Formation	From	To	No. of Shots	Formation	From	To	Size of Shot

CASING RECORD

Amount Set						Amount Pulled		Packer Record			
Size	Wt.	Thds.	Make	Ft.	In.	Ft.	In.	Size	Length	Depth Set	Make
8 5/8	28	8	LW	165				None			

Liner Record: Amount _____ Kind _____ Top _____ Bottom _____

CEMENTING AND MUDDING

Size	Amount Set		Sacks Cement	Chemical		Method of Cementing	Amount	Mudding Method	Results (See Note)
	Ft.	In.		Gal.	Make				
8 5/8	165		100						

Note: What method was used to protect sands if outer strings were pulled? _____

NOTE: Were bottom hole plugs used? _____ If so, state kind, depth set and results obtained _____

TOOLS USED

Rotary Tools were used from _____ feet to _____ feet, and from _____ feet to _____ feet, and from _____ feet to _____ feet.

Type Rig _____

INITIAL PRODUCTION TEST

Describe initial test: whether by flow through tubing or casing or by pumping _____

Amount of Oil Production _____ bbls. Size of choke, if any _____ Length of test _____ Water

Production _____ bbls. Gravity of oil _____ Type of Pump or pump is used, describe _____

Formation	Top	Bottom	Formation	Top	Bottom
Cellar	9	150			
Shale	150	750			
Sand	750	880			
Shale & Sand	880	1050			
Sand & Shale	1050	1330			
Shale & Redbed	1330	1490			
Shale	1490	1608			
Anhydrite	1608	1645			
Shale & RedBed	1645	1930			
Shells & Redbed	1930	2140			
Shale & Shells	2140	2510			
Shale & Lime	2510	3350			
Lime & Shale	3350	3470			
Lime	3470	3723			
Cherty Conglomerate	3723	3780			

TOPS:

Elevation 2180 R. B.
 Heebner 3420
 Toronto 3440
 Lansing 3457
 Cherty Cong. 3723
 Total Depth 3790

D & A

I, the undersigned, being first duly sworn upon oath, state that this well record is true, correct and complete according to the records of this office and to the best of my knowledge and belief.

John W. Farmer
 Name and title of representative of company
 Vice-President

Subscribed and sworn to before me this 13th day of August 1952
 My Commission expires April 25, 1956
Bonnie Berryhill
 Notary Public

FARM NAME Sutor C
 WELL NO. 1
 COUNTY Rooks
 SEC. 24
 TWP. 10S
 RGE. 20W
 15-63-00609-0000