

STATE OF KANSAS
STATE CORPORATION COMMISSION

WELL PLUGGING RECORD

Give All Information Completely
Make Required Affidavit
Mail or Deliver Report to:
Conservation Division
State Corporation Commission
800 Bitting Building
Wichita, Kansas

Graham County. Sec. 24 Twp. 10 Rge. (E) 21(W)

Location as "NE/CNW&SW&" or footage from lines SW NE NE

Lease Owner Jones, Shelburne & Farmer, Inc.

Lease Name Paul C Well No. 1

Office Address Russell, Kansas

Character of Well (completed as Oil, Gas or Dry Hole) dry

Date well completed 11-23 19 55

Application for plugging filed 11-23 19 55

Application for plugging approved 11-23 19 55


Plugging commenced 11-23 19 55

Plugging completed 11-23 19 55

Reason for abandonment of well or producing formation dry

If a producing well is abandoned, date of last production never produced 19

Was permission obtained from the Conservation Division or its agents before plugging was commenced? yes

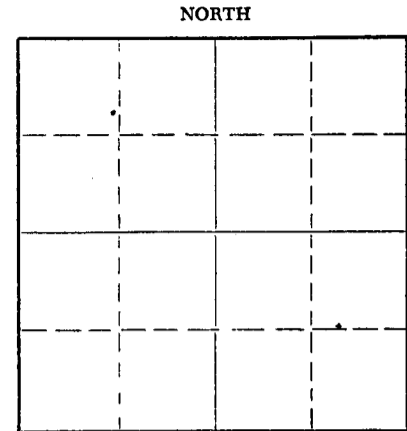

Locate well correctly on above Section Plat

Name of Conservation Agent who supervised plugging of this well Eldon Petty

Producing formation _____ Depth to top _____ Bottom _____ Total Depth of Well 3850 Feet

Show depth and thickness of all water, oil and gas formations.

OIL, GAS OR WATER RECORDS

CASING RECORD

FORMATION	CONTENT	FROM	TO	SIZE	PUT IN	PULLED OUT
				8 5/8	165	None

Describe in detail the manner in which the well was plugged, indicating where the mud fluid was placed and the method or methods used in introducing it into the hole. If cement or other plugs were used, state the character of same and depth placed, from _____ feet to _____ feet for each plug set.

1. Filled hole with heavy mud
2. Pushed plug to 165'
3. Dumped 1/2 sack hulls on top of plug
4. Mixed 15 sacks cement and dumped on top of hulls
5. Filled hole to top
6. Pushed plug to 40'
7. Dumped in 1/2 sack hulls
8. Mixed 10 sacks cement and filled hole to top with same

(If additional description is necessary, use BACK of this sheet)

Name of Plugging Contractor Jones, Shelburne & Farmer, Inc.

Address Russell, Kansas

STATE OF Kansas, COUNTY OF Russell, ss.
John O. Farmer (employee of owner) or (owner or operator) of the above-described

well, being first duly sworn on oath, says: That I have knowledge of the facts, statements, and matters herein contained and the log of the above-described well as filed and that the same are true and correct. So help me God.

(Signature) John O. Farmer
Russell, Kansas
(Address)

SUBSCRIBED AND SWORN TO before me this 1st day of December, 1955

Bonnie Pratt Notary Public.

My commission expires July 14, 1958

PLUGGING
SEC 24 T 10 R 21 W
BOOK PAGE LINE 15
19

RECEIVED
STATE CORPORATION COMMISSION
DEC 2 - 1955
CONSERVATION DIVISION
Wichita, Kansas

