

15-065-02461-0000


STATE OF KANSAS
STATE CORPORATION COMMISSION

WELL PLUGGING RECORD

Give All Information Completely
Make Required Affidavit
Mail or Deliver Report to:
Conservation Division
State Corporation Commission
800 Biting Building
Wichita, Kansas

Graham County. Sec. 24 Twp. 10S Rge. 21 (E) W (W)
Location as "NE/CNW/SE/SW" or footage from lines SW NE NW
Lease Owner C-G DRILLING CO. - D. G. Hansen
Lease Name Zetterholm Well No. 1
Office Address 107 Rule Building
Character of Well (completed as Oil, Gas or Dry Hole) dry hole
Date well completed March 14 19 55
Application for plugging filed March 14 19 55
Application for plugging approved March 14 19 55
Plugging commenced March 15 19 55
Plugging completed March 15 19 55
Reason for abandonment of well or producing formation Too low structurally

NORTH

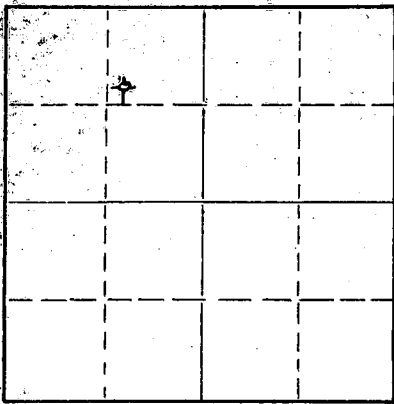

Locate well correctly on above
Section Plat

If a producing well is abandoned, date of last production _____ 19____
Was permission obtained from the Conservation Division or its agents before plugging was com-
menced? Yes

Name of Conservation Agent who supervised plugging of this well Eldon Petty, Hays, Kansas
Producing formation _____ Depth to top _____ Bottom _____ Total Depth of Well 3847 Feet
Show depth and thickness of all water, oil and gas formations.

OIL, GAS OR WATER RECORDS

CASING RECORD

FORMATION	CONTENT	FROM	TO	SIZE	PUT IN	PULLED OUT
				8-5/8"	183.87'	None

Describe in detail the manner in which the well was plugged, indicating where the mud fluid was placed and the method or methods used in introducing it into the hole. If cement or other plugs were used, state the character of same and depth placed, from _____ feet to _____ feet for each plug set.

Filled hole with mud to 178'; set plug, 1/2 sack hulls, 15 sacks cement. Filled hole with mud to 40'; set plug, then filled to top with 10 sacks cement, 1/2 sack hulls.


(If additional description is necessary, use BACK of this sheet)

Name of Plugging Contractor C-G Drilling Co.
Address 107 Rule Building, Wichita, Kansas

STATE OF KANSAS, COUNTY OF SEDGWICK, ss.
R. A. Cook (employee or owner) or (owner or operator) of the above-described well, being first duly sworn on oath, says: That I have knowledge of the facts, statements, and matters herein contained and the log of the above-described well as filed and that the same are true and correct. So help me God.

(Signature) R. A. Cook
107 Rule Building, Wichita, Kansas
(Address)

SUBSCRIBED AND SWORN to before me this 16th day of March, 1955
My commission expires June 25, 1955
Wichita, Kansas Notary Public.

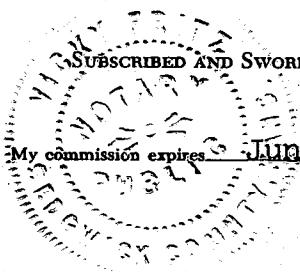

PLUGGING
FILE SEC 24 T 10 R 21W
BOOK PAGE 102 LINE 19

RECEIVED
STATE CORPORATION COMMISSION
MAR 18 1955
CONSERVATION DIVISION
Wichita, Kansas

CONTRACTOR'S WELL LOG

OPERATOR C-G Drilling Co. FARM NAME Zetterholm
 LOCATION SW/4 NE/4 NW/4 Sec. 24-10S-21W
 POOL NAME Wildcat COUNTY GRAHAM STATE KANSAS
 COMMENCEMENT DATE March 7, 1955 COMPLETION DATE MARCH 14, 1955

LOG OF WELL

Elevation: 2212 R. B.

All measurements from the top of rotary bushing.

FROM	TO	FORMATION	DEVIATION FROM VERTICAL	REMARKS:
0	183	Sand-Shale		
183	500	Shale		
500	810	Shale		
810	910	Sand		
910	1140	Shale-Sand		
1140	1380	Sand		
1380	1440	Sandy Shale		
1440	1686	Shale-Shells	0° - 1500'	
1686	1726	Anhydrite		
1726	1800	Shale-Red Bed		
1800	2100	Lime-Shale	0° - 2000'	
2100	2350	Lime-Shale		
2350	2465	Lime-Shale		
2465	2570	Lime-Shale	0° - 2500'	
2570	2790	Lime-Shale		
2790	2905	Lime-Shale		
2905	3090	Lime-Shale	0° - 3000'	
3090	3245	Lime-Shale		
3245	3360	Lime-Shale		
3360	3430	Lime-Shale		
3430	3515	Lime-Shale	0° - 3500'	
3515	3563	Lime-Shale		
3563	3618	Lime-Shale		
3618	3680	Lime-Shale		
3680	3740	Lime-Shale		
3740	3790	Lime-Shale		
3790	3847	Lime-Shale		

CASING LEFT IN HOLE AFTER COMPLETION

Ran 183.87' (6 jts.) 8/ 5/8" OD Surface Casing.

STATE OF KANSAS, COUNTY OF SEDGWICK) ss.

The undersigned certifies that to the best of his knowledge and belief, the above facts are true and correct.

C-G DRILLING CO.

By R G Cook

Subscribed and sworn to before me this 16th day of March, 1955.

My commission expires June 25, 1955.

Wick Fritz
Notary Public



PLUGGING
 PER SEC 24 T 10 R 21W
 BOOK PAGE 105 LINE 12