

ORIGINAL

SIDE ONE

STATE CORPORATION COMMISSION OF KANSAS
OIL & GAS CONSERVATION DIVISION
RECOMPLETION FORM
ACO-2 AMENDMENT TO WELL HISTORY

API NO. 15- 065-01759-0001

County Graham

SE NW NE Sec 23 Twp. 10S Rge. 21 East West

4290 Ft. North from Southeast Corner of Section

1650 Ft. West from Southeast Corner of Section
(NOTE: Locate well in section plat below.)

Lease Name Pierce Well # 2

Field Name Cooper

Producing Formation Topeka/KC/Arb

Elevation: Ground 2186 KB 2191

Operator: License # 4707

Name: Carl Boxberger Oil, Inc.

Address: P. O. Box 1604

City/State/Zip: Great Bend, KS 67530

Purchaser: Mobile Oil

Operator Contact Person: Keith Lumpkins
Phone: (316) 793-6032

Designate Type of Original Completion
 New Well Re-Entry Workover

Date of Original Completion 4-13-81

Name of Original Operator Derby Oil Co.

Original Well Name Pierce #2

Date of Recompletion: _____

Commenced 12/7/90 Completed 1/5/91


Re-entry Workover

Designate Type of Recompletion/Workover:
 Oil SWD Temp. Abd.
 Gas Inj Delayed Comp.
 Dry Other (Core, Water Supply, etc.)

Deepening Re-perforation
 Plug Back PBTD
 Conversion to Injection/Disposal

Is recompleted production:
 Commingled Docket No. _____
 Dual Completion Docket No. _____
 Other (Disposal or Injection?) Docket No. _____

RECEIVED
STATE CORPORATION COMMISSION
APR 30 1991
CONSERVATION DIVISION
Wichita, Kansas

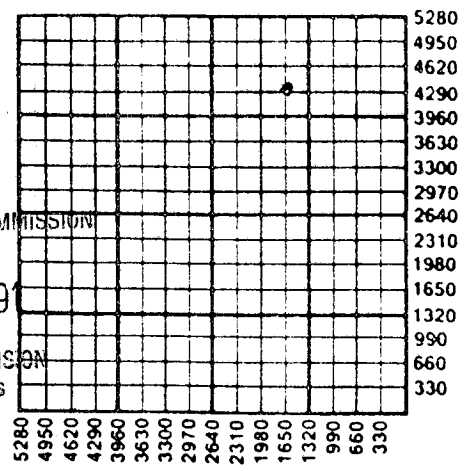

K.C.C. OFFICE USE ONLY
F Letter of Confidentiality Attached
C Wireline Log Received
C Drillers Timelog Received
Distribution
 KCC SWD/Rep NGPA
 KGS Plug- Other (Specify)


INSTRUCTIONS: This form shall be completed in triplicate and filed with the Kansas Corporation Commission, 200 Colorado Derby Building, Wichita, Kansas 67202, within 120 days of the recompletion of any well. Rules 82-3-107 and 82-3-141 apply. Information on side two of this form will be held confidential for a period of 12 months if requested in writing and submitted with the form. See rule 82-3-107 for confidentiality in excess of 12 months. One copy of any additional wireline logs and driller's time logs (not previously submitted) shall be attached with this form. Submit ACO-4 or ACO-5 prior to or with this form for approval of commingling or dual completions. Submit CP-1 with all plugged wells. Submit CP-111 with all temporarily abandoned wells. NOTE: Conversion of wells to either disposal or injection must receive approval before use; submit form U-1.

All requirements of the statutes, rules and regulations promulgated to regulate the oil and gas industry have been fully complied with and the statements herein are complete and correct to the best of my knowledge.

Signature Carl Boxberger Title President Date 1/28/91

Subscribed and sworn to before me this 28thth day of January 1991

Notary Public Dianne M. Willesden Date Commission Expires 6/28/93

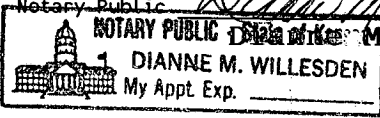

SIDE TWO

Operator Name Carl Boxberger Oil, Inc. Lease Name Pierce Well # 2

Sec. 23 Twp. 10S Rge. 21

East
 West

County Graham

RECOMPLETION FORMATION DESCRIPTION

Log Sample

Name	Top	Bottom
KC	3440	3652
Topeka	3196	3404

ADDITIONAL CEMENTING/SQUEEZE RECORD

Purpose:	Depth		Type of Cement	# Sacks Used	Type and Percent Additives
	Top	Bottom			
<input checked="" type="checkbox"/> Perforate					
<input type="checkbox"/> Protect Casing					
<input type="checkbox"/> Plug Back TD					
<input type="checkbox"/> Plug Off Zone					

Shots Per Foot	Specify Footage of Each Interval Perforated	PERFORATION RECORD	Acid, Fracture, Shot, Cement Squeeze Record
			(Amount and Kind of Material Used)
4	3634 - 3638		500 gal 15% NE
4	3316 - 3319		1500 gal 15% NE

PBTD _____ Plug Type _____

TUBING RECORD

Size _____ Set At _____ Packer At _____ Was Liner Run _____ Y _____ N _____

Date of Resumed Production, Disposal or Injection 1/5/91

Estimated Production Per 24 Hours Oil 6 Bbls. Water 80 Bbls. 0 Gas-Oil-Ratio

Gas 0 Mcf

Disposition of Gas:

Vented Sold Used on Lease (If vented, submit ACO-18.)