

STATE OF KANSAS  
STATE CORPORATION COMMISSION

WELL PLUGGING RECORD

Give All Information Completely  
Make Required Affidavit  
Mail or Deliver Report to:  
Conservation Division  
State Corporation Commission  
800 Bitting Building  
Wichita, Kansas

Graham County, Sec. 35 Twp. 10 Rge. 21 (E) (W)

Location as "NE/CNW/SW" or footage from lines NW NW NE

Lease Owner Harry Gore

Lease Name Lewis Well No. 2-C

Office Address 400 Brown Bldg. Wichita, Kansas

Character of Well (completed as Oil, Gas or Dry Hole) Dry Hole

Date well completed 8-26 1953

Application for plugging filed 8-26 1953

Application for plugging approved 8-26 1953


Plugging commenced 8-26 1953

Plugging completed 8-26 1953

Reason for abandonment of well or producing formation Dry Hole

If a producing well is abandoned, date of last production \_\_\_\_\_ 19\_\_\_\_

Was permission obtained from the Conservation Division or its agents before plugging was commenced? Yes

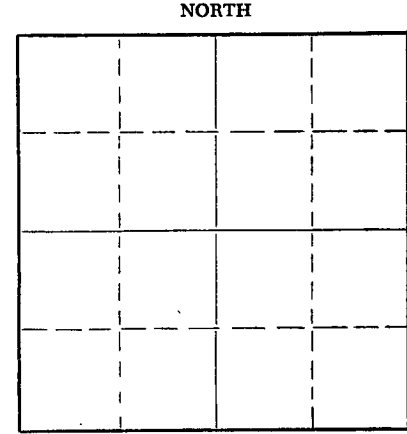

Locate well correctly on above  
Section Plat

Name of Conservation Agent who supervised plugging of this well Chas. Stough

Producing formation \_\_\_\_\_ Depth to top \_\_\_\_\_ Bottom \_\_\_\_\_ Total Depth of Well 3760' Feet

Show depth and thickness of all water, oil and gas formations.

OIL, GAS OR WATER RECORDS

CASING RECORD

FORMATION	CONTENT	FROM	TO	SIZE	PUT IN	PULLED OUT
				8 5/8"	210'	Cemented 125 sacks cement

Describe in detail the manner in which the well was plugged, indicating where the mud fluid was placed and the method or methods used in introducing it into the hole. If cement or other plugs were used, state the character of same and depth placed, from \_\_\_\_\_ feet to \_\_\_\_\_ feet for each plug set.

Filled to 208' with mud - set plug with 1/2 sack hulls - 20 sacks cement.  
Filled to 40' with heavy mud - set plug with 1/2 sack hulls - 10 sacks cement.

RECEIVED  
STATE CORPORATION COMMISSION

09-01-53

CONSERVATION DIVISION

(If additional description is necessary, use BACK of this sheet)

Name of Plugging Contractor Veeder Supply & Development Company

Address P. O. Box 201, Cherryvale, Kansas

STATE OF Kansas, COUNTY OF Montgomery, ss.

Floyd W. Hild (employee of owner) or (~~sworn operator~~) of the above-described well, being first duly sworn on oath, says: That I have knowledge of the facts, statements, and matters herein contained and the log of the above-described well as filed and that the same are true and correct. So help me God.

(Signature) Veeder Supply & Development Company

By: Floyd W. Hild

Cherryvale, Kansas (Address)


SUBSCRIBED AND SWORN to before me this 29th day of August, 1953

Glen Lawson  
Notary Public.

My commission expires July 11, 1953

**PLUGGING**  
FILE SEC-35 T-10 R-214  
BOOK PAGE 125 LINE 20

Veeder Supply & Dev'l. Co.

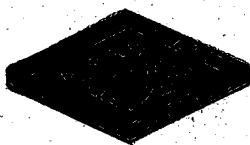

Cherryvale, Kansas

Drilled for Harry Gere, et al Farm Lewis No. 2-C Depth 3760'  
 Contractor Veeder Supply & Development Co. Pipe Set 210' of 8 5/8" casing - cemented with 125 sacks cement.  
 Location NW NW NE Sec. 35 Twp. 10 Range 21  
 Commenced 8-15-1953 Completed 8-26-1953 County Graham State Kansas

				Elevation: 2117 RB
Soil, clay	0	40	40	
Gray shale	40	90	50	Tops:
Sand	90	105	15	
Shale	105	210	105	Topeka 3157 - 1040
Blue shale	210	420	210	Heebner 3365 - 1240
Shale, shells	420	720	300	Toronto 3592 - 1275
Shale, shells, sand	720	1100	380	Kansas City 3409 - 1292
Sand	1100	1270	170	Hase Kan.C. 3652 - 1615
Shale, sand	1270	1330	60	Ch. Cong 3572 - 1355
Shale, shells	1330	1580	250	Arbuckle
Anhydrite	1580	1620	40	(weathered) 3703 - 1386
Shale, lime, shells	1620	2340	720	Arbuckle
Lime, shale	2340	2880	540	(solid) 3732 - 1615
Lime, shale, shells	2880	2980	100	
Lime, shale	2980	3180	200	
Lime	3180	3680	500	DRY AND ABANDONED
Lime cherty	3680	3706	26	
Lime (Arb)	3706	3760	54	

Filled to 208' with mud - set plug with 1/2 sack hulls - 20 sacks cement.  
 Filled to 40' with heavy mud set plug with 1/2 sack hulls - 10 sacks cement.

AFFIDAVIT

STATE OF KANSAS )  
 Montgomery County) SS

Floyd W. Hild, of lawful, being duly and solemnly sworn on oath, deposes and says:

I am a resident of Cherryvale, Montgomery County, Kansas, and I hereby know and on oath state that the above drilling log covering the Lewis 2-C Well in Section 35-10-21, Graham County, Kansas, is true and correct. Further affiant saith not.

THE VEEDER SUPPLY & DEVELOPMENT COMPANY,

BY: Floyd W. Hild  
 Floyd W. Hild

Subscribed and sworn to before me this 29th day of August, 1953.

Loles Lawson  
 Notary Public

My commission expires July 11, 1956.

RECEIVED  
 STATE COMMISSION  
 AUG 31 1953  
 STATE COMMISSION DIVISION  
 Wichita, Kansas

**PLUGGING**  
 FILE SEC 35 T 10 R 214  
 BOOK PAGE 125 LINE 20