


WELL PLUGGING RECORD

Give All Information Completely
Make Required Affidavit
Mail or Deliver Report to:
Conservation Division
State Corporation Commission
800 Biting Building
Wichita, Kansas

NORTH

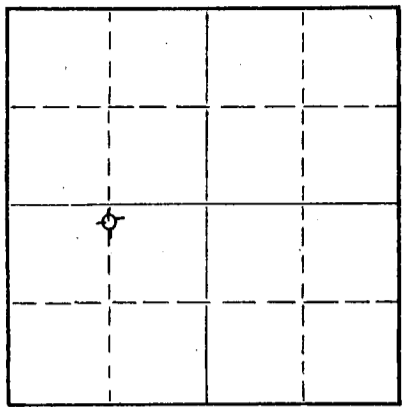

Locate well correctly on above
Section Plat

Graham County. Sec. 35 Twp. 10S Rge. 21 (E) W (W)
Location as "NE/CNW/SW" or footage from lines N/2 N/2 SW/4
Lease Owner C-G Drilling Co. & D. G. Hansen
Lease Name Zeigler Well No. 2
Office Address 107 Rule Building, Wichita, Kansas
Character of Well (completed as Oil, Gas or Dry Hole) dry hole
Date well completed March 22, 1955
Application for plugging filed March 22, 1955
Application for plugging approved March 22, 1955
Plugging commenced March 22, 1955
Plugging completed March 22, 1955
Reason for abandonment of well or producing formation Too low structuraly

If a producing well is abandoned, date of last production -- 19---
Was permission obtained from the Conservation Division or its agents before plugging was commenced? Yes

Name of Conservation Agent who supervised plugging of this well Eldon Petty, Hays, Kansas
Producing formation -- Depth to top -- Bottom -- Total Depth of Well 3723 Feet
Show depth and thickness of all water, oil and gas formations.

OIL, GAS OR WATER RECORDS

CASING RECORD

FORMATION	CONTENT	FROM	TO	SIZE	PUT IN	PULLED OUT
				8-5/8"	183.38'	none

Describe in detail the manner in which the well was plugged, indicating where the mud fluid was placed and the method or methods used in introducing it into the hole. If cement or other plugs were used, state the character of same and depth placed, from _____ feet to _____ feet for each plug set.

Filled hole with mud to 180'. Set plug.
Put in 1/2 sack Hulls and 15 sacks cement.
Filled hole with mud to 40'; set plug then
filled to top with 1/2 sack hulls and 10
sacks cement.

03.20-55

(If additional description is necessary, use BACK of this sheet)

Name of Plugging Contractor C G DRILLING CO.
Address 107 Rule Bldg., Wichita, Kansas



STATE OF KANSAS, COUNTY OF SEDGWICK, ss.
R. A. Cook (employee or owner) or (owner or operator) of the above-described well, being first duly sworn on oath, says: That I have knowledge of the facts, statements, and matters herein contained and the log of the above-described well as filed and that the same are true and correct. So help me God.

(Signature) R. A. Cook
107 Rule Bldg., Wichita, Kansas
(Address)

SUBSCRIBED AND SWORN TO before me this 23rd day of March, 1955

My commission expires June 25, 1955

Ucky Lutz
Notary Public.

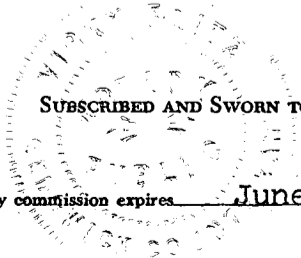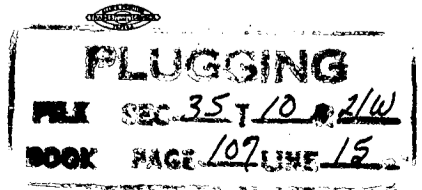

CONTRACTOR'S WELL LOG

OPERATOR C-G Drilling & D. G. Hansen FARM NAME Zeigler #2

LOCATION Center N/2 N/2 SW/4 Sec. 35-10S-21W

POOL NAME Wildcat COUNTY Graham STATE KANSAS

COMMENCEMENT DATE March 14, 1955 COMPLETION DATE March 22, 1955

LOG OF WELL

Elevation: 2114 R.B.

All measurements from the top of rotary bushing.

FROM	TO	FORMATION	DEVIATION FROM VERTICAL	REMARKS:
0	183	Sand-Shale		
183	850	Shale		
850	1060	Shale-Sand		
1060	1310	Sand		
1310	1576	Red Bed	0° - 1500'	
1576	1610	Anhydrite		
1610	1615	Anhydrite		
1615	2065	Shale-Shells	0° - 2000'	
2065	2270	Shale-Shells		
2270	2475	Shale-Lime		
2475	2625	Lime-Shale	0° - 2500'	
2625	2805	Lime-Shale		
2805	2940	Lime-Shale		
2940	3065	Lime-Shale	0° - 3000'	
3065	3205	Lime-Shale		
3205	3310	Lime-Shale		
3310	3365	Lime-Shale		
3365	3435	Lime-Shale		
3435	3508	Lime-Shale	0° - 3500'	
3508	3563	Lime-Shale		
3563	3618	Lime-Shale		
3618	3683	Lime-Shale		
3683	3703	Lime-Shale		
3703	3706	Lime-Shale		DST 3706-(from 3702 to 3706.
3706	3713	Lime-Shale		DST 3704-13
3713	3723	Lime-Shale		

CASING LEFT IN HOLE AFTER COMPLETION

Ran 6 jts. (183.38') 8-5/8" OD Surface Casing.

STATE OF KANSAS, COUNTY OF SEDGWICK) ss.

The undersigned certifies that to the best of his knowledge and belief, the above facts are true and correct.

C-G DRILLING CO.

By R.G. Cook

Subscribed and sworn to before me this 23rd day of March, 1955.

My commission expires June 25, 1955.

Vicky Fritz
Notary Public

