

STATE OF KANSAS
STATE CORPORATION COMMISSION

WELL PLUGGING RECORD

OR


FORMATION PLUGGING RECORD

Strike out upper line
when reporting plug-
ging off formations.

Give All Information Completely
State Required Affidavit
Mail or Deliver Report to:
Conservation Division
State Corporation Commission
800 Bittling Building
Wichita, Kansas

Graham County. Sec. 24 Twp 10S Rge. 21 (E) W (W)
Location as "NE 1/4 NW 1/4 SW 1/4" or footage from lines SW SW NW
Lease Owner Anderson-Prichard Oil Corporation
Lease Name Klewer Well No. 1
Office Address Oklahoma City, Oklahoma
Character of Well (completed as Oil, Gas or Dry Hole) Dry Hole
Date well completed July 5, 1947
Application for plugging filed (Verbal) July 5, 1947
Application for plugging approved (Verbal) July 5, 1947
Plugging commenced July 5, 1947
Plugging completed July 5, 1947
Reason for abandonment of well or producing formation Dry Hole

NORTH

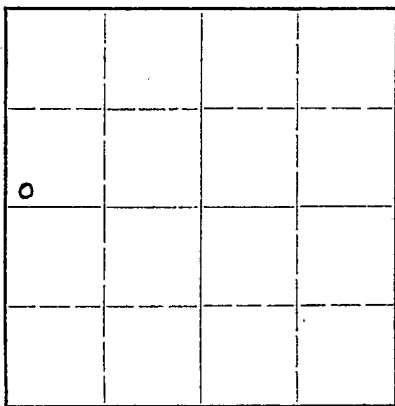

Locate well correctly on above
Section Plat

If a producing well is abandoned, date of last production 19
Was permission obtained from the Conservation Division or its agents before plugging was com-
menced? Yes

Name of Conservation Agent who supervised plugging of this well
Producing formation Depth to top Bottom Total Depth of Well 3870 Feet
Show depth and thickness of all water, oil and gas formations.

OIL, GAS OR WATER RECORDS

CASING RECORD

Formation	Content	From	To	Size	Put In	Pulled Out
				8 5/8	254	None

Describe in detail the manner in which the well was plugged, indicating where the mud fluid was placed and the method or methods used in introducing it into the hold. If cement or other plugs were used, state the character of same and depth placed, from feet to feet for each plug set.

Filled hole with heavy mud from T. D.
to 256 ft. Set bridging plug at 256 ft.
and 15 sack cement plug on top. Filled
holes to top with heavy mud. Set bridging
plug at 7 ft. with 10 sack cement plug on
top. 5 sacks cement in bottom of cellar.

(If additional description is necessary, use BACK of this sheet)

Correspondence regarding this well should be addressed to Anderson-Prichard Oil Corporation
Address Oklahoma City, Oklahoma

STATE OF KANSAS, COUNTY OF SEDGWICK, ss.
H. W. Smith (employee of owner) or (owner or operator) of the above-described well,

being first duly sworn on oath, says: That I have knowledge of the facts, statements, and matters herein contained and the log of the above-described well as filed and that the same are true and correct. So help me God.


(Signature) *H. W. Smith*

(Address) 07-12-47

SUBSCRIBED AND SWORN to before me this 10th day of July 1947

Laticia Decker
Notary Public.

My commission expires January 21, 1950

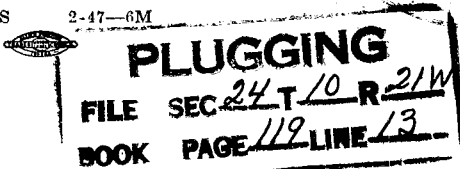

15-065-00021-0000

DRILLERS LOG OF FORMATIONS ENCOUNTERED IN

ANDERSON-PRICHARD OIL CORPORATION

INEZ Z. KLEWER NO. 1

C-SW/4 SW/4 NW/4 SEC. 24-10S-21W

GRAHAM COUNTY, KANSAS

<u>FORMATIONS</u>	<u>FROM</u>	<u>TO</u>
Surface Clay	0	20
Clay & Shells	20	40
Clay, Shale & Shells	40	262
Shale & Shells	262	290
Brown Shale	290	560
Soft Lime & White Sand	560	700
Sand	700	915
Sandy Shale	915	1400
Shale & Shells	1400	1550
Shale	1550	1655
Anhydrite	1655	1835
Shale & Shells	1835	1875
Shale & Lime	1875	1975
Sand & Lime	1975	2015
Broken Lime	2015	2100
Shale	2100	2240
Lime	2240	2335
Shale	2335	2360
Shale & Lime	2360	3100
Lime	3100	3390
Lime & Shale	3390	3450
Lime	3450	3715
Lime & Shale	3715	3805
Lime	3805	3817
Lime & Chert	3817	3870

Set 8-5/8" Casing @
262' and Cemented w/
200 Sacks Cement

D & A

T.D. 3870

Contractor - Transit Corporation
Apco Tower
Oklahoma City, Okla.

I hereby certify the foregoing to be a true and correct
driller's log of the formations encountered in the above well.

M. C. Yeaman
M. C. Yeaman

JUL 26 1947

Certified to before me this 24th day of July, 1947

Betty Jane Beata
Notary Public

My Commission Expires *March 7-1951*

PLUGGING
FILE SEC 24 T 10 R 21W
BOOK 119 PAGE 13