


WELL PLUGGING RECORD

Give All Information Completely
Make Required Affidavit
Mail or Deliver Report to:
Conservation Division
State Corporation Commission
211 No. Broadway
Wichita, Kansas

Rocks _____ County. Sec. 24 Twp. 10S Rge. _____ (E) 20 (W)

Location as "NE/CNWxSWx" or footage from lines. SE SE SW
Lease Owner Nadel and Gussman
Lease Name Earl Well No. 1
Office Address 1714 First National Bldg., Tulsa, Oklahoma
Character of Well (completed as Oil, Gas or Dry Hole) Dry Hole
Date well completed April 6, 1956 19 56
Application for plugging filed April 23 19 56
Application for plugging approved April 24 19 56
Plugging commenced April 30 19 56
Plugging completed May 2 19 56
Reason for abandonment of well or producing formation Dry Hole

NORTH

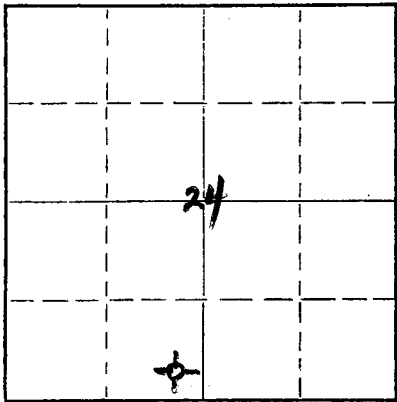

Locate well correctly on above Section Plat

If a producing well is abandoned, date of last production _____ 19 _____
Was permission obtained from the Conservation Division or its agents before plugging was commenced? Yes

Name of Conservation Agent who supervised plugging of this well Eldon Petty
Producing formation _____ Depth to top _____ Bottom _____ Total Depth of Well 3743 Feet
Show depth and thickness of all water, oil and gas formations.

OIL, GAS OR WATER RECORDS

CASING RECORD

FORMATION	CONTENT	FROM	TO	SIZE	PUT IN	PULLED OUT
				8 5/8"	166'	None
				5 1/2"	3738'	2702'

RECEIVED
STATE CORPORATION COMMISSION
MAY 10 1956
CONSERVATION DIVISION
WICHITA, KANSAS

Describe in detail the manner in which the well was plugged, indicating where the mud fluid was placed and the method or methods used in introducing it into the hole. If cement or other plugs were used, state the character of same and depth placed, from _____ feet to _____ feet for each plug set.

Dumped 5 sacks cement on bottom. Filled with mud to 160'.
Filled with 20 sacks of cement through surface pipe to top.
Filled top with 5 sacks of cement, capped and levelled.

(If additional description is necessary, use BACK of this sheet)

Name of Plugging Contractor Barnes & Sons
Address Russell, Kansas

STATE OF Oklahoma, COUNTY OF Tulsa, ss.
Herbert Gussman (employee of owner) or (owner or operator) of the above-described well, being first duly sworn on oath, says: That I have knowledge of the facts, statements, and matters herein contained and the log of the above-described well as filed and that the same are true and correct. So help me God.

(Signature) [Signature]
1714 First National Building, Tulsa 3, Oklahoma
(Address)

SUBSCRIBED AND SWORN to before me this 4th day of May, 19 56

My commission expires April 1, 1957

[Signature]
Notary Public.

PLUGGING
FILE SEC 24 T 10 R 20 W
BOOK 56 LINE 26

15-163-00955-0000

WELL LOG

Nadel and Gussman

Karl No. 1

SE SE SW 24-10-20W
Reels County, Kansas

Comm: 3-28-56
Comp: 4-6-56

Casing: 8-5/8" 166' w/125 s&x
5-1/2" 3738' w/125 s&x

Shale	170
Shale and shells	780
Sand	850
Shale and shells	1100
Sand	1175
Shale and shells	1590
Anhydrite	1625
Shale and red bed	1740
Shale and shells	1965
Shale and lime	2915
Shale	3050
Lime and shale	3392
Lime	3720
Arbuckle	3743

GEOLOGICAL TOPS

Hechmer Shale	3393
Toronto Lime	3413
Lansing-K.C.	3491
Base Kansas City	3638
Bonglomerate	3678
Simpson Shale	3713
Arbuckle	3736

STATE OF KANSAS }
COUNTY OF SEDGWICK } ss:

E. G. McNeil, of lawful age, states that the above depths and formations are correct to his best knowledge and belief.

E. G. McNeil
E. G. McNeil

Subscribed and sworn to before me this 9th day of April, 1956.

Nola Babb
Nola Babb, Notary Public

My commission expires Nov. 3, 1956

RECEIVED
STATE CORPORATIONS COMMISSION
APR 27 1956
CONSERVATION DIVISION
Wichita, Kansas

PLUGGING
WELL SEC 24 T 10 R 20W
BOOK PAGE 56 LINE 26