


WELL PLUGGING RECORD

Give All Information Completely
Make Required Affidavit
Mail or Deliver Report to:
Conservation Division
State Corporation Commission
800 Bittling Building
Wichita, Kansas

NORTH

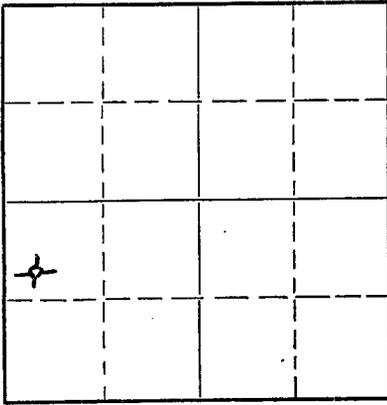

Locate well correctly on above
Section Plat

Graham County. Sec. 24 Twp. 10S Rge. 21 (E) W (W)
Location as "NE/CNW/SW" or footage from lines SW NW SW
Lease Owner Anderson-Prichard Oil Corporation
Lease Name Acheson Well No. 6
Office Address Liberty Bank Building, Oklahoma City, Oklahoma
Character of Well (completed as Oil, Gas or Dry Hole) Dry Hole
Date well completed July 4, 1954
Application for plugging filed July 4, 1954
Application for plugging approved July 4, 1954
Plugging commenced July 4, 1954
Plugging completed July 4, 1954
Reason for abandonment of well or producing formation Dry Hole

If a producing well is abandoned, date of last production _____ 19____
Was permission obtained from the Conservation Division or its agents before plugging was commenced? Yes

Name of Conservation Agent who supervised plugging of this well Eldon Petty
Producing formation _____ Depth to top _____ Bottom _____ Total Depth of Well 3778 Feet
Show depth and thickness of all water, oil and gas formations.

OIL, GAS OR WATER RECORDS

CASING RECORD

FORMATION	CONTENT	FROM	TO	SIZE	PUT IN	PULLED OUT
		0	245	8 5/8"	245	None

Describe in detail the manner in which the well was plugged, indicating where the mud fluid was placed and the method or methods used in introducing it into the hole. If cement or other plugs were used, state the character of same and depth placed, from _____ feet to _____ feet for each plug set.


From 3778' to 241 1/2' - Heavy rotary mud
241 1/2' to 240' - Wooden plug
240' to 194' - 15 sacks cement, 1/2 sack hulls
194' to 41 1/2' - Heavy rotary mud
41 1/2' to 40' - Wooden plug
40' to 6' - 10 sacks cement, 1/2 sack hulls
6' to surface cellar

(If additional description is necessary, use BACK of this sheet)
Name of Plugging Contractor Glenn W. Peel
Address P.O. Box 359, Hoisington, Kansas

STATE OF KANSAS, COUNTY OF BARTON, ss.
Glenn W. Peel (employee of owner) or (~~owner~~) of the above-described well, being first duly sworn on oath, says: That I have knowledge of the facts, statements, and matters herein contained and the log of the above-described well as filed and that the same are true and correct. So help me God. GLENN W. PEEL
(Signature) BY: [Signature]
P.O. Box 359, Hoisington, Kansas
(Address)

SUBSCRIBED AND SWORN TO before me this 8th day of July, 19 54

My commission expires June 4, 1955 Mania M. Hubert Notary Public.

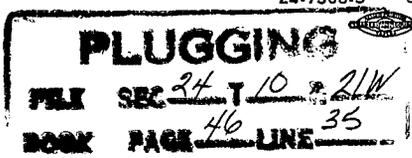

07-12-54

DRILLERS' LOG

Company: Anderson-Brichard Oil Corp.

SW NW SW
Sec. 24, Twp. 10S, Rge. 21W,

Farm Name: Acheson Well No. 6

County: Graham,
Kansas

Total Depth: 3778'

Elevation:

Comm: 6-23-54 Comp. 7-4-54

Contractor: Glenn W. Peel

Production: Dry

Casing: 8 5/8" 245' Cem.

Figures below indicate bottom of formations:

Surface clay	-0-	40
Sand and shale		100
Shale		500
Sand and shale		775
Sand		920
Shale and sand		1220
Shale		1430
Shale, red bed and shells		1640
Anhydrite		1685
Shale and shells		2275
Lime and shale		2310
Lime		2605
Lime and shale		2785
Lime		3090
Shale and lime		3210
Lime		3745
Lime and arbuckle		3778
Total Depth		3778

This is to certify that the above information is to the best of our knowledge, true and correct.

GLENN WL PEEL

BY: Glenn W. Peel

SUBSCRIBED AND SWORN to before me this 8th day of July, 1954.

My commission expires: June 4, 1955

Morris M. Hubert
Notary Public

