


STATE OF KANSAS
STATE CORPORATION COMMISSION

All Information Completely
State Required Affidavit
Must be Delivered Report to
Conservation Division
State Corporation Commission

P. O. Box 17027
Wichita, Kansas 67217

WELL PLUGGING RECORD

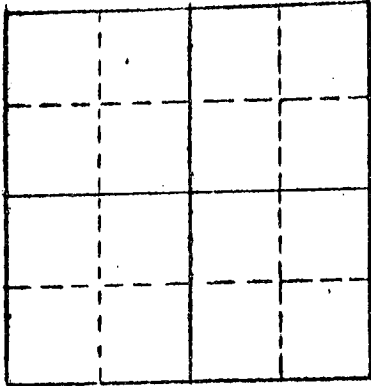

Locate well correctly on above
Section Plat

Rooks County, Sec. 24 Twp. 10 Rge. 20 (E) (W)
Location as "NE/CNW/SE/SW" or footage from lines NE NW NE
Lease Owner Southern States Oil Co.
Lease Name Sutor A#3 Well No.
Office Address Great Bend, Kansas 67530
Character of Well (completed as Oil, Gas or Dry Hole)
Date well completed 19
Application for plugging filed 19
Application for plugging approved 19
Plugging commenced 7/18/74 19
Plugging completed 7/24/74 19
Reason for abandonment of well or producing formation depleted.
If a producing well is abandoned, date of last production 19
Was permission obtained from the Conservation Division or its agents before plugging was commenced? yes

Name of Conservation Agent who supervised plugging of this well Wassey
Producing formation Depth to top Bottom Total Depth of Well 3759 Feet
Show depth and thickness of all water, oil and gas formations.

OIL, GAS OR WATER RECORDS

CASING RECORD

FORMATION	CONTENT	FROM	TO	SIZE	PUT IN	PULLED OUT
				8-5/8	193	none
				5 1/2"	3756	489

Describe in detail the manner in which the well was plugged, indicating where the mud fluid was placed and the method or methods used in introducing it into the hole. If cement or other plugs were used, state the character of same and depth placed, from feet to feet for each plug set.

Checked hole and sanded back to 3740', dumped 5 sacks cement.
Shot pipe at 605', 542', 480', pulled 16 joints of 5 1/2". Allied pumped 1 sack hulls, 20 sacks mud and 100 sacks cement.

PLUGGING COMPLETE

RECEIVED
STATE CORPORATION COMMISSION

AUG 19 1974

CONSERVATION DIVISION
Wichita, Kansas

Name of Plugging Contractor KNIGHT CASING PULLING CO., INC.
Address CHASE, KANSAS

STATE OF KANSAS COUNTY OF RICE
NOEL J. KNIGHT (employee of owner) or (owner or operator) of the above-described

well, being first duly sworn on oath, says: That I have knowledge of the facts, statements, and matters herein contained and the log of the above-described well as filed and that the same are true and correct. So help me God.

(Signature) Noel Knight
CHASE, KANSAS

Subscribed and Sworn to before me this 31st day of July 74

Margaret Melcher
Notary Public.

MARGARET MELCHER
NOTARY PUBLIC
Rice County, Kansas
My Commission Expires
Feb. 15, 1975



15-163-19018-0000

SUTOR "A" NO. 3 WELL

LOCATION: NE $\frac{1}{4}$ NW $\frac{1}{4}$ NE $\frac{1}{4}$ Sec. 24-10-20W
Rocks County, Kansas

OPERATOR: Birmingham-Bartlett Drilling Co.

CONTRACTOR: Birmingham-Bartlett Drilling Co.

SURFACE CASING: Ran 7 jts. 201' 8-5/8" rd. thrd. casing cemented @ 193' with 160 sacks bulk cement and 2 cc.

OIL STRING: Ran 119 jts., 3762.76' 5 1/2" 15# 8 rd. thrd. casing cemented @ 3756 with 175 sacks bulk cement

DATE SPUDDED: 10-3-49

DATE COMPLETED: 10-15-49

TOTAL DEPTH: 3759'

LOG

(Figures indicate bottom of formation)

0	to	15	Clay and sand
		193	Shale and sand
		810	Shale
		1150	Sand and shale
		1350	Sand
		1620	Shale, shells and red bed
		1650	Anhydrite
		2100	Shale and shells
		2400	Shale
		2465	Lime and shale
		2555	Lime
		2630	Lime and shale
		3190	Shale
		3300	Lime and shale
		3685	Lime
		3729	Conglomerate
		3755	Conglomerate and shale
		3759	Arbuckle

RECEIVED
STATE CORPORATION COMMISSION

JAN 25 1974

CONSERVATION DIVISION
Wichita, Kansas

The undersigned RICHARD HINDERY of the BIRMINGHAM-BARTLETT DRILLING CO. hereby certifies that the above is a true and correct log of the formations encountered in drilling the Sutor "A" No. 3 well as shown on the daily drilling tickets.

BIRMINGHAM-BARTLETT DRILLING CO.

BY Richard Hindery

Sworn and subscribed before me this
18th day of October, 1949.

Vincent J. Zinger
Notary public

My commission expires November 29, 1950.