


WELL PLUGGING RECORD

- Give All Information Completely
Make Required Affidavit
Mail or Deliver Report to:
Conservation Division
State Corporation Commission
800 Bitting Building
Wichita, Kansas

Graham County, Sec. 24 Twp. 10S Rge. 21 X W (W)

Location as "NE/CNW¹/₄SW¹/₄" or footage from lines NW NW NE
Lease Owner C-G DRILLING CO.
Lease Name HOLZHAUER Well No. 2
Office Address 206 Union Nat'l Bank Bldg., Wichita, Kansas
Character of Well (completed as Oil, Gas or Dry Hole) Dry Hole
Date well completed August 18, 19 52
Application for plugging filed August 18, 19 52
Application for plugging approved August 18, 19 52
Plugging commenced August 18, 19 52
Plugging completed August 18, 19 52
Reason for abandonment of well or producing formation too low structurally.

NORTH

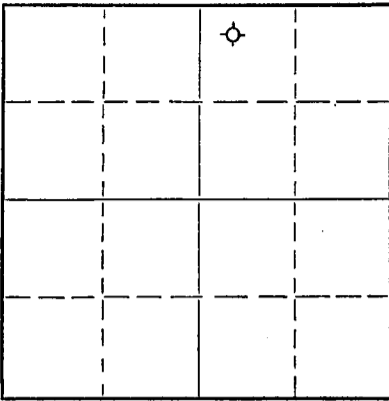

Locate well correctly on above Section Plat

If a producing well is abandoned, date of last production ---- 19
Was permission obtained from the Conservation Division or its agents before plugging was commenced? yes

Name of Conservation Agent who supervised plugging of this well Eldon Petty, Hays, Kansas
Producing formation ---- Depth to top -- Bottom -- Total Depth of Well -- Feet
Show depth and thickness of all water, oil and gas formations.

OIL, GAS OR WATER RECORDS

CASING RECORD

Formation	Content	From	To	Size	Put In	Pulled Out
				8 5/8"	165'	

Describe in detail the manner in which the well was plugged, indicating where the mud fluid was placed and the method or methods used in introducing it into the hole. If cement or other plugs were used, state the character of same and depth placed, from ---- feet to ---- feet for each plug set.

Hole filled with mud to 160' of top. Set plug at 150', put in 1/2 sack hulls, 15 sacks cement. Filled with mud within 40' of top; 1/2 sack hulls, 10 sacks cement.

(If additional description is necessary, use BACK of this sheet)

Name of Plugging Contractor Lohmann-Johnson Drilling Co., Inc.
Address 320 Indiana Bank Building, Evansville, Indiana

STATE OF KANSAS, COUNTY OF SEDGWICK, ss.
Vicky Fritz (employee of owner) or (owner or operator) of the above-described well, being first duly sworn on oath, says: That I have knowledge of the facts, statements, and matters herein contained and the log of the above-described well as filed and that the same are true and correct. So help me God.

(Signature) Vicky Fritz, office mgr.
Union Nat'l Bank Bldg., Wichita, Kansas
(Address)

SUBSCRIBED AND SWORN TO before me this 4th day of September, 1952

My commission expires November 21, 1955

23-8390-s

6-51-20M

Notary Public.



PLUGGING CONSERVATION DIVISION
FILE SEC 24 T 10 R 21 W
BOOK PAGE 39 LINE 7

HOLZHAUER #2

Location: *Graham County* ~~Reeks County~~, Kansas, *NW NW NE Sec. 24-108-21W*
 Operator: C & G Drilling Co.
 Contractor: Lohmann-Johnson Drilling Co., Inc.
 Commenced: August 6, 1952
 Completed: August 18, 1952
 Casing Record: 165' Surface pipe with 125 sack lone star cement
 Production : D & A

LOG

FROM	TO	FORMATION
0	185	Sand & shells
185	845	Shale & shells
845	985	Sand
985	1120	Shale
1120	1180	Shale
1180	1420	Shale & shells & sand
1420	1510	Shale & shells
1510	1750	Red Bed
1750	2250	Broken lime & shale
2250	2400	Broken lime
2400	2520	Lime & shale
2520	2645	Lime & shale
2645	2788	Shale & lime
2788	2790	Lime & shale
2790	2845	Broken lime
2845	2955	Sahel & lime
2955	3088	Shale & lime
3088	3199	Broken lime
3199	3266	Lime & shale
3266	3451	Lime & shale
3451	3509	Lime
3509	3562	Lime
3562	3615	Lime & shale
3615	3655	Lime & Conglomerate
3655	3720	Lime
3720	3768	Lime
3768	3803	Lime & chert
3803	3850	Conglomerate

I, the undersigned, being first duly sworn upon oathe, state that this well record is true, correct and complete according to the records of this office and to the best of my knowledge and belief.

D. Given

 D. Given

Subscribed and sworn to before me this 2nd day of

September, 1952.

My Commission Expires:

October 14, 1953.

Art M. Trump

 Notary Public

RECEIVED
 THE CORPORATION COMMISSION
 SEP 5 - 1952
 CONSERVATION DIVISION
 DEPT. OF REVENUE

PLUGGING
 WELL SEC. 24 T. 10 R. 21 W.
 PAGE 39 LINE 7