


Give All Information Completely
Make Required Affidavit
Mail or Deliver Report to:
Conservation Division
State Corporation Commission
800 Bitting Building
Wichita, Kansas

WELL PLUGGING RECORD

NORTH

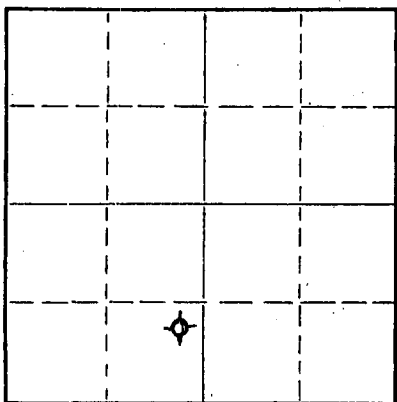

Locate well correctly on above
Section Plat

Graham County. Sec. 35 Twp. 10S Rge. 21 (E) W (W)
Location as "NE/CNW%SW%" or footage from lines NE SE SW
Lease Owner C-G Drilling Co. & D. G. Hansen
Lease Name Zeigler Well No. 3
Office Address 107 Rule Bldg., Wichita, Kansas
Character of Well (completed as Oil, Gas or Dry Hole) Dry Hole
Date well completed October 10 1955
Application for plugging filed October 10 1955
Application for plugging approved October 10 1955
Plugging commenced October 11 1955
Plugging completed October 11 1955
Reason for abandonment of well or producing formation Top low structually

If a producing well is abandoned, date of last production _____ 19____
Was permission obtained from the Conservation Division or its agents before plugging was commenced? Yes

Name of Conservation Agent who supervised plugging of this well Eldon Petty, Hays, Kansas
Producing formation _____ Depth to top _____ Bottom _____ Total Depth of Well 3701 Feet
Show depth and thickness of all water, oil and gas formations.

OIL, GAS OR WATER RECORDS

CASING RECORD

FORMATION	CONTENT	FROM	TO	SIZE	PUT IN	PULLED OUT
				8-5/8	175'	none

Describe in detail the manner in which the well was plugged, indicating where the mud fluid was placed and the method or methods used in introducing it into the hole. If cement or other plugs were used, state the character of same and depth placed, from _____ feet to _____ feet for each plug set.

Filled hole with heavy mud to 170'.
Set plug. Put in 1/2 sack Hulls and 15 sacks of
cement. Filled with heavy mud up to 40'. Set plug.
Filled to top with 1/2 sack hulls and 10 sacks cement.

(If additional description is necessary, use BACK of this sheet)

Name of Plugging Contractor C-G Drilling Co.
Address 107 Rule Bldg., Wichita, Kansas

STATE OF Kansas, COUNTY OF Sedgwick, ss.
Jay H. Galloway (employee of owner) or (owner or operator) of the above-described


well, being first duly sworn on oath, says: That I have knowledge of the facts, statements, and matters herein contained and the log of the above-described well as filed and that the same are true and correct. So help me God.

(Signature) Jay H. Galloway
107 Rule Building
(Address)

Subscribed and Sworn to before me this 17th day of October, 1955

My commission expires May 20, 1959

Vicky Jacobs
Vicky Jacobs Notary Public.

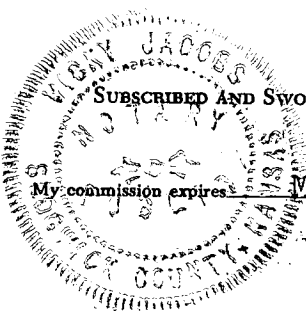

PLUGGING
FILE SEC 35 T 10 R 21W
BOOK PAGE 2 LINE 43

CONTRACTOR'S WELL LOG

OPERATOR C-G DRILLING CO. & D. G. HANSEN WELL NAME ZEIGLER

WELL LOCATION NE SE SW 35-10S-21W RIG #2

COUNTY GRAHAM STATE KANSAS

COMMENCEMENT DATE SEPTEMBER 30, 1955 COMPLETION DATE OCTOBER 11, 1955

LOG OF WELL

Elevation 2105 rotary bushing.

All measurements from the top of rotary bushing.

FROM	TO	FORMATION	DEVIATION FROM VERTICAL	REMARKS
	75	Sand-Shale		
75	173	Sand Shale		
173	620	Shale-Shells		
620	650	Red Bed		
650	675	Shale-Shells		
675	760	Sand-		
760	790	Shale-Shells		
790	900	Shale-Shells		
900	1245	Sand-Shells		
1245	1370	Shale-Shells		
1370	1553	Shale-RedBed		
1553	1585	Anhydrite		
1585	1610	Anhydrite		
1610	1855	Shale-Shells		
1855	2005	Shale-Shells		
2005	2165	Shale-Lime		
2165	2345	Shale-Lime		
2345	2460	Shale-Lime		
2460	2475	Shale-Lime		
2475	2700	Shale-Lime	0° -2500'	
2700	2805	Shale-Lime		
2805	2855	Shale-Lime		
2855	2980	Shale-Lime		
2980	3065	Shale-Lime		
3065	3172	Shale-Lime	0° - 3000'	
3172	3259	Shale-Lime		
3259	3315	Lime		
3315	3359	Shale-Lime		
3359	3405	Shale-Lime		
3405	3451	Lime		
3451	3497	Lime		
3497	3517	Shale-Lime	0° - 3500'	
3517	3568	Lime		
3568	3611	Lime		
3611	3661	Shale-Lime		
3661	3680	Shale-Lime		
3680	3701	Shale-Lime		

CASING LEFT IN HOLE AFTER COMPLETION

Set 175' of 8-5/8" OD Surface Casing

STATE OF KANSAS, COUNTY OF SEDGWICK) ss.

The undersigned certifies that to the best of his knowledge and belief, the above facts are true and correct.

PLUGGING
 SEC 35 T10 R21W
 PAGE 7 LINE 23

C-G DRILLING CO.

By Jay H. Galloway
 Jay H. Galloway

Subscribed and sworn to before me this 13th day of October, 1955.

My commission expires: 5/20/59

Vicky Jacobs
 Vicky Jacobs, Notary Public