


STATE OF KANSAS
STATE CORPORATION COMMISSION
Give All Information Completely
Make Required Affidavit
Mail or Deliver Report to:
Conservation Division
State Corporation Commission
800 Bittling Building
Wichita, Kansas

WELL PLUGGING RECORD

Graham County, Sec. 3 Twp. 10S Rge. 22 (E) (W)
Location as "NE/CNW $\frac{1}{4}$ SW $\frac{1}{4}$ " or footage from lines SW $\frac{1}{4}$ SW $\frac{1}{4}$ SW $\frac{1}{4}$
Lease Owner Barnett Drilling, Inc., et al
Lease Name Rice Estate Well No. 1
Office Address 417 First Nat'l. Bank Bldg., Wichita, Kansas.
Character of Well (completed as Oil, Gas or Dry Hole) Dry Hole
Date well completed January 25 19 51
Application for plugging filed January 25 19 51
Application for plugging approved January 25 19 51
Plugging commenced January 25 19 51
Plugging completed January 25 19 51
Reason for abandonment of well or producing formation Dry Hole

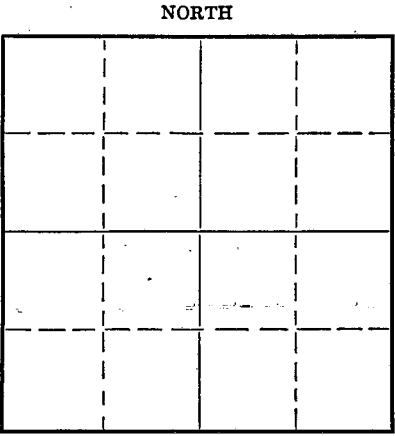

Locate well correctly on above Section Plat

If a producing well is abandoned, date of last production - 19
Was permission obtained from the Conservation Division or its agents before plugging was commenced? Yes

Name of Conservation Agent who supervised plugging of this well Eldon Petty
Producing formation Depth to top Bottom Total Depth of Well 4120 Feet
Show depth and thickness of all water, oil and gas formations.

OIL, GAS OR WATER RECORDS

CASING RECORD

Formation	Content	From	To	Size	Put In	Pulled Out
Surface Casing				8 5/8"	150 ft.	None

Describe in detail the manner in which the well was plugged, indicating where the mud fluid was placed and the method or methods used in introducing it into the hole. If cement or other plugs were used, state the character of same and depth placed, from feet to feet for each plug set.

Filled hole with heavy mud from 4120 feet to 150 feet. Set wooden plug at 150 feet and filled surface casing with 15 sacks of cement to 103 feet. Filled surface casing with heavy mud from 103 feet to 40 feet. Set wooden plug at 40 feet and filled surface casing with 10 sacks of cement to bottom of cellar.

RECEIVED
STATE CORPORATION COMMISSION
FEB 3 1951
CONSERVATION DIVISION
Wichita, Kansas

(If additional description is necessary, use BACK of this sheet)
Correspondence regarding this well should be addressed to Barnett Drilling, Inc.
Address 417 First Nat'l. Bank Bldg., Wichita, Kansas.

STATE OF Kansas, COUNTY OF Sedgwick, ss.
W. R. Hunter (employee of owner) or (owner or operator) of the above-described well, being first duly sworn on oath, says: That I have knowledge of the facts, statements, and matters herein contained and the log of the above-described well as filed and that the same are true and correct. So help me God.

(Signature) W. R. Hunter
417 First Nat'l. Bank Bldg., Wichita, Kansas.
(Address)

SUBSCRIBED AND SWORN to before me this 30th day of January, 19 51
My commission expires May 12, 1951.
Adelaide Olivier Notary Public.



PLUGGING
FILE SEC 3 T10 R 22
BOOK PAGE 58 LINE 39

BARNETT DRILLING, INC., ET AL

LOG OF RICE ESTATE WELL NO. 1

SW $\frac{1}{4}$ SW $\frac{1}{4}$ SW $\frac{1}{4}$ SECTION 3-10S-22W, GRAHAM COUNTY, KANSAS

COMMENCED: JANUARY 11, 1951

COMPLETED: JANUARY 25, 1951

<u>Formation</u>	<u>From</u>	<u>To</u>	<u>Remarks</u>
Clay	-0-	30	
Sand	30	35	
Yellow Rock	35	50	
Shale	50	120	
Shale and Shells	120	950	Set 8 5/8" 21# surface casing at 150 feet; cemented with 125 sacks of cement.
Sand and Shells	950	1050	
Shale and Shells	1050	1350	
Sand	1350	1570	
Shale and Shells	1570	1850	
Anhydrite	1850	1895	
Shale and Shells	1895	2340	
Lime and Shale	2340	3560	
Lime	3560	3860	
Lime and Shale	3860	3910	
Lime	3910	3938	
Lime and Shale	3938	3980	
Shale	3980	4004	
Cherty Conglomerate	4004	4040	
Conglomerate	4040	4120	
Total Depth		4120	Dry and abandoned.

CERTIFICATE

I, W. R. Hunter, Vice-President of Barnett Drilling, Inc., hereby certify that to the best of my knowledge and belief the above is a true and correct log of the Rice Estate Well No. 1, located in the SW $\frac{1}{4}$ SW $\frac{1}{4}$ SW $\frac{1}{4}$ of Section 3-10S-22W, Graham County, Kansas.

W. R. Hunter

Subscribed and sworn to before me, a Notary Public, in and for the County of Sedgwick, State of Kansas, this 30th day of January, 1951.

Adelaide Olivier
Notary Public.

My commission expires May 12, 1951.

RECEIVED
STATE CORPORATION COMMISSION
FEB 3 1951
CONSERVATION DIVISION
Wichita, Kansas

PLUGGING
FILE SEC 3 T10 RW
BOOK PAGE 58 LINE 39