

WELL PLUGGING RECORD

SE NW NW

Give All Information Completely
Make Required Affidavit
Mail or Deliver Report to:
Conservation Division
State Corporation Commission
211 No. Broadway
Wichita, Kansas

Graham County, Sec. 36 Twp. 10 Rge. 21 XXX (W)

Location as "NE/CNW&SW" or footage from lines. 1065 S of N L & 1500 W of E Line

Lease Owner Theodore Gore NW of 36

Lease Name C. V. Lewis Well No. 8

Office Address 650 Fourth National Building

Character of Well (completed as Oil, Gas or Dry Hole) Dry Hole

Date well completed Sept. 7, 19 61

Application for plugging filed Verbally Sept. 7, 19 61

Application for plugging approved Verbally Sept. 7, 19 61


Plugging commenced Sept. 7, 19 61

Plugging completed Sept. 7, 19 61

Reason for abandonment of well or producing formation Dry Hole

If a producing well is abandoned, date of last production 19

Was permission obtained from the Conservation Division or its agents before plugging was commenced? Yes

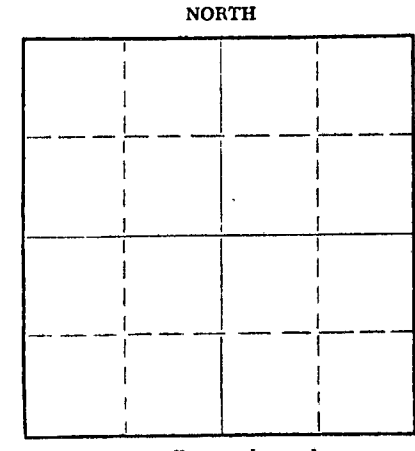

Locate well correctly on above Section Plat

Name of Conservation Agent who supervised plugging of this well Eldon Petty

Producing formation Depth to top Bottom Total Depth of Well 3780 Feet

Show depth and thickness of all water, oil and gas formations.

OIL, GAS OR WATER RECORDS

CASING RECORD

FORMATION	CONTENT	FROM	TO	SIZE	PUT IN	PULLED OUT
				10 3/4"	168'	None

Describe in detail the manner in which the well was plugged, indicating where the mud fluid was placed and the method or methods used in introducing it into the hole. If cement or other plugs were used, state the character of same and depth placed, from feet to feet for each plug set.

Plug set at 540' w/ 20 sacks cement
Plug set at 150' w/ 20 sax cement
Plug set at 40' w/ 10 sax cement

RECEIVED
STATE CORPORATION COMMISSION
SEP 22 1961
CONSERVATION DIVISION
Wichita, Kansas

(If additional description is necessary, use BACK of this sheet)
Name of Plugging Contractor Empire Drilling Company
Address 650 Fourth National Building, Wichita 2, Kansas

STATE OF KANSAS, COUNTY OF SEDGWICK, ss.
Dan J. Kornfeld (employee of owner) of the above-described well, being first duly sworn on oath, says: That I have knowledge of the facts, statements, and matters herein contained and the log of the above-described well as filed and that the same are true and correct. So help me God.

(Signature) Dan J. Kornfeld
650 Fourth National Building, Wichita 2, Kansas (Address)

SUBSCRIBED AND SWORN TO before me this 21st day of September, 19 61
My commission expires Oct. 21, 1962

Lucille H. Harr
Notary Public.



LOG

COMPANY: Theodore Gore
 CONTRACTOR: Empire Drilling Company
 FARM: C. V. Lewis #8
 LOCATION: 1065' So. of No. Line and 1500' W of E Line, NW of 36-10-21, Graham County, Kansas
 COMMENCED: August 21, 1961 ELEVATION: 2154 KB
 COMPLETED: September 7, 1961 POTENTIAL: D & A

0	to	275	Shale-Sand
275	to	338	Shale
338	to	7000	Shale-Sand
700	to	800	Sand
800	to	975	Shale-Shells (Pyrite)
975	to	980	Pyrite
980	to	1010	Pyrite-Sand-Shale
1010	to	1290	Shale-Sand
1290	to	1599	Shale-Shells
1599	to	1640	Anhydrite
1640	to	2160	Shale-Shells
2160	to	3320	Shale-Lime
3320	to	3390	Lime
3390	to	3430	Shale-Lime
3430	to	3500	Lime
3500	to	3550	Lime-Shale
3550	to	3580	Lime
3580	to	3601	Lime-Chert-Shale
3601	to	3740	Lime-Shale
3740	to	3780	Arbuckle
3780			R.T.D.

SET: 168' of 10 3/4" Casing w/ 115 sacks cement.


ELECTRIC LOG TOPS:


Heebner	3382	-1228
Toronto	3409	-1255
Lansing	3424	-1270
Base Kansas City	3652	-1498
Conglomerate	3708	-1554
Reworked Arbuckle	3720	-1566
Arbuckle in Place	3762	-1608
Schlumberger TD	3780	



CERTIFICATION

I, Dan J. Kornfeld, do hereby certify that the above and foregoing is a true and correct copy of the log on the C. V. Lewis #8 located in the Northwest Quarter of Sec. 36-10S-21W., Graham County, Kansas, as reflected by the files of Empire Drilling Company.

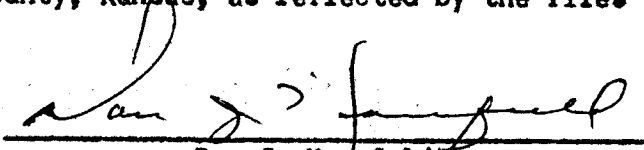
 Dan J. Kornfeld

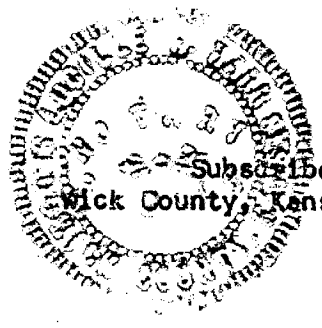

Subscribed and sworn to before me, a Notary Public, within and for Sedgwick County, Kansas, this 21st day of September, 1961.

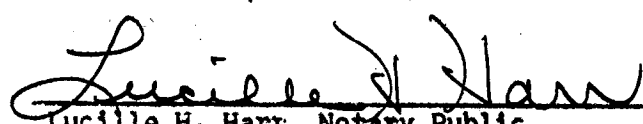
 Lucille H. Harr, Notary Public

My commission expires Oct. 21, 1962.