

CARD MUST BE TYPED

State of Kansas

CARD MUST BE SIGNED

NOTICE OF INTENTION TO DRILL

(see rules on reverse side)

Starting Date ²⁵ Nov ¹⁸ 1986
month day year

API Number 15- ~~065-01015~~ ⁰¹⁷¹³⁻⁰⁰⁰¹

OPERATOR: License # 4984
Name Micheal A. Davignon
Address Box 150
City/State/Zip Bogue Kansas 67625
Contact Person Micheal A. Davignon
Phone 913-674-3387

_____ East
E/2 NW. NE. Sec. 10. Twp. 10. S, Rg. 21. ~~West~~
4620 Ft. from South Line of Section
1650 Ft. from East Line of Section

(Note: Locate well on Section Plat on reverse side)

CONTRACTOR: License # 6997
Name Bill's Well Service Inc.
City/State Codell Kansas

Nearest lease or unit boundary line 330 feet
County Graham

Well Drilled For: Well Class: Type Equipment:
 Oil SWD Infield Mud Rotary
 Gas Inj Pool Ext. Air Rotary
 OWWO Expl Wildcat Cable

Lease Name Bartos Well # 4
Ground surface elevation 2268 feet MSL
Domestic well within 330 feet: yes no
Municipal well within one mile: yes no

If OWWO: old well info as follows:
Operator Rocket Schusterman Oil Acct.
Well Name Bartos #4
Comp Date 3-1-51 Old Total Depth 3826

Depth to bottom of fresh water 180
Depth to bottom of usable water 9000
Surface pipe by Alternate: 1-2
Surface pipe ~~planned~~ set 239
Conductor pipe required
Projected Total Depth 3750 feet
Formation L-KC

I certify that well will comply with K.S.A. 55-101, et seq., plus eventually plugging hole to KCC specifications.

Date 11-15-86 Signature of Operator or Agent Micheal Davignon Title OWNER

For KCC Use:

Conductor Pipe Required _____ feet; Minimum Surface Pipe Required 139 feet per Alt. 6 2
This Authorization Expires 5-18-87 Approved By 11-18-86


[Handwritten Signature]

Must be filed with the K.C.C. five (5) days prior to commencing well
This card void if drilling not started within six (6) months of date received by K.C.C.

Important procedures to follow:

1. Notify District office before setting surface casing.
2. Set surface casing by circulating cement to the top.
3. File completion forms ACO-1 with K.C.C. within 90 days of well completion, following instructions on ACO-1, side 1, and including copies of wireline logs.
4. Notify District office 48 hours prior to old well workover or re-entry.
5. Prior to filing Intent to plug, prepare a proposed plugging plan in case well is D & A, then obtain approval of plan when calling district office prior to setting surface pipe.
6. Submit plugging report (CP-4) to K.C.C. after plugging is completed.
7. Obtain an approved injection docket number before disposing of salt water.
8. Notify K.C.C. within 10 days when injection commences or terminates.
9. If an alternate 2 completion, cement in the production pipe from below any usable water to surface within 120 days of spud date.

A Regular Section of Land 1 Mile = 5,280 Ft.

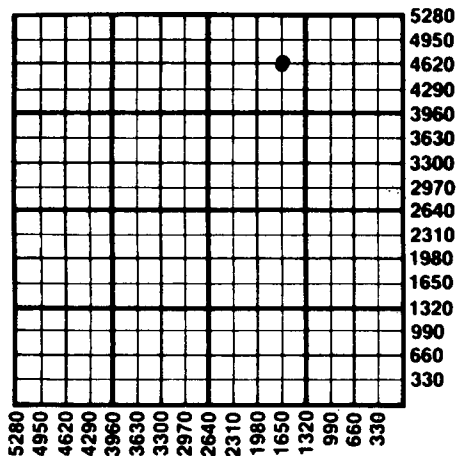

NOV 18 1986
STATE CORPORATION COMMISSION

[NOV] 18 1986

11-18-86

State Corporation Commission of Kansas
Conservation Division
200 Colorado Derby Building
Wichita, Kansas 67202
(316) 263-3238