

TYPE

AFFIDAVIT OF COMPLETION FORM

ACO-1 WELL HISTORY

Compt. _____

SIDE ONE

Two (2) copies of this form shall be filed with the Kansas Corporation Commission, 200 Colorado Derby Building, Wichita, Kansas 67202, within thirty (30) days after the completion of a well, regardless of how the well was completed.

F Attach separate letter of request if the information is to be held confidential. If confidential, only file one copy. Information on Side One will be of public record and Side Two will then be held confidential.

Applications must be made on dual completion, commingling, salt water disposal, injection and temporarily abandoned wells.

C Attach one copy only wireline logs (i.e. electrical log, sonic log, gamma ray neutron log, etc.). (Rules 82-2-105 & 82-2-125) KCC# (316) 263-3238. No Log

LICENSE # 5465 EXPIRATION DATE 6-30-85

OPERATOR John B. Collins API NO. 15-065-01004 -0001

ADDRESS 1007 Cody - Suite A COUNTY Graham
Hays, KS 67601 FIELD Cooper


** CONTACT PERSON Gloria J. Brown PROD. FORMATION Arbuckle
PHONE 913-628-1046

PURCHASER Farmland Industries, Inc. LEASE Miller

ADDRESS Dept. #4 P. O. Box 7305 WELL NO. 9
Kansas City, MO 64116 WELL LOCATION SE SW SW

DRILLING Superior Well Service #7733 330 Ft. from South Line and
CONTRACTOR P. O. Box 276 990 Ft. from West Line of
ADDRESS Plainville, KS 67663 the SW (Qtr.) SEC 3 TWP 10 RGE 21 (W).

PLUGGING
CONTRACTOR
ADDRESS

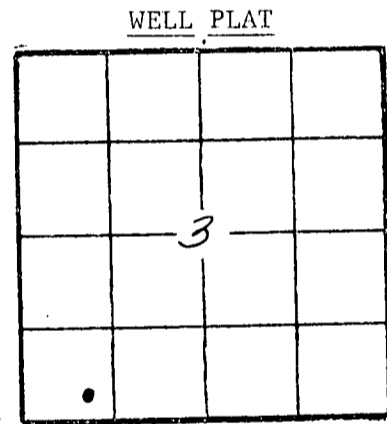

(Office Use Only)
KCC
KGS
SWD/REP
PLG.

TOTAL DEPTH 3205' PBD 3818'

SPUD DATE 7-11-84 DATE COMPLETED 7-30-84

ELEV: GR 2237 DF KB 2242

DRILLED WITH (CABLE) (ROTARY) (AIR) TOOLS.

DOCKET NO. OF DISPOSAL OR REPRESSURING WELL BEING USED TO DISPOSE OF WATER FROM THIS LEASE

Amount of surface pipe set and cemented 200 DV Tool Used?

THIS AFFIDAVIT APPLIES TO: (Circle ONE) - Oil, Gas, Shut-in Gas, Dry, Disposal, Injection, Temporarily Abandoned, (OWWO). Other Open hole.

ALL REQUIREMENTS OF THE STATUTES, RULES AND REGULATIONS PROMULGATED TO REGULATE THE OIL AND GAS INDUSTRY HAVE BEEN FULLY COMPLIED WITH.


A F F I D A V I T

John B. Collins, being of lawful age, hereby certifies that:

I am the Affiant, and I am familiar with the contents of the foregoing Affidavit. The statements and allegations contained therein are true and correct.

John B. Collins (Name)

SUBSCRIBED AND SWORN TO BEFORE ME this 30th day of August, 1984.

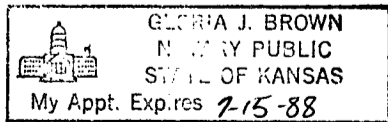

Gloria J. Brown (NOTARY PUBLIC)

MY COMMISSION EXPIRES: 7-15-88

RECEIVED

** The person who can be reached by phone regarding any questions is _____ information.

AUG 31 1984

CONSERVATION DIVISION
Wichita, Kansas

SIDE TWO

OPERATOR John B. Collins

LEASE Miller

ACO-1 WELL HISTORY X(IX)

SEC. 3 TWP. 10 RGE. 21(W)

FILL IN WELL INFORMATION AS REQUIRED:

WELL NO. 9

Show all important zones of porosity and contents thereof; cored intervals, and all drill-stem tests, including depth interval tested, cushion used, time tool open, flowing and shut-in pressures, and recoveries.

SHOW GEOLOGICAL MARKERS, LOGS RUN, OR OTHER DESCRIPTIVE INFORMATION.

FORMATION DESCRIPTION, CONTENTS, ETC.	TOP	BOTTOM	NAME	DEPTH
X Check if no Drill Stem Tests Run.	Depth	Datum		
Heebner	3440	-1198		
Lansing	3480	-1238		
B/KC	3706	-1464		
Cong	3755	-1513		
Simp	3788	-1546		
Arb	3807	-1565		
T.D.	3905	-1663		

If additional space is needed use Page 2, Side 2

Report of all strings set — surface, intermediate, production, etc. **CASING RECORD** (New) or (Used)

Purpose of string	Size hole drilled	Size casing set (in O.D.)	Weight lbs/ft.	Setting depth	Type cement	Sacks	Type and percent additives
Surface	12 1/4	8 5/8"		200'			
Production	7 7/8	5 1/2		3905			
Liner		4 1/2		3816	common	175 50	50/50 6% gel
						235	

LINER RECORD

PERFORATION RECORD

Top, ft.	Bottom, ft.	Sacks cement	Shots per ft.	Size & type	Depth interval

TUBING RECORD		
Size	Setting depth	Packer set at

ACID, FRACTURE, SHOT, CEMENT SQUEEZE RECORD

Amount and kind of material used	Depth interval treated

Date of first production	Producing method (flowing, pumping, gas lift, etc.)	Gravity
Estimated Production -I.P.	Oil bbls.	Gas bbls.
Disposition of gas (vented, used on lease or sold)	Water % MCF	Gas-oil ratio CFPB
Perforations		