


STATE OF KANSAS
STATE CORPORATION COMMISSION

Form CP-4

Give All Information Completely.
Make Required Affidavit
Mail or Deliver Report to:
Conservation Division
State Corporation Commission
212 No. Market
Wichita, Kansas

WELL PLUGGING RECORD

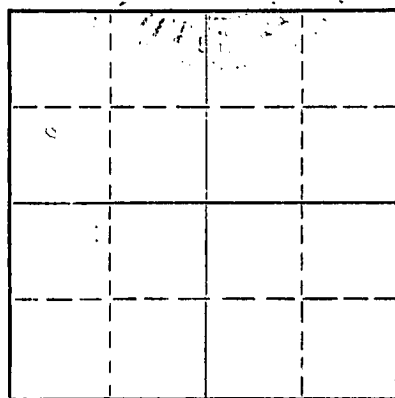

Locate well correctly on above
Section Plat

Graham County. Sec. 7 Twp. 10 Rge. 21 (E) (W) x
Location as "NE/CNW/SW" or footage from lines SE SE SE
Lease Owner D. G. Hansen
Lease Name McElroy Well No. #1
Office Address Box 187, Logan, Kansas
Character of Well (completed as Oil, Gas or Dry Hole) _____
Date well completed _____ 19____
Application for plugging filed 7-28-67 19____
Application for plugging approved _____ 19____
Plugging commenced 8-9-67 19____
Plugging completed 8-14-67 19____
Reason for abandonment of well or producing formation _____

If a producing well is abandoned, date of last production _____ 19____
Was permission obtained from the Conservation Division or its agents before plugging was commenced? _____

Name of Conservation Agent who supervised plugging of this well W. L. Nichols
Producing formation _____ Depth to top _____ Bottom _____ Total Depth of Well 3842' Feet
Show depth and thickness of all water, oil and gas formations.

OIL, GAS OR WATER RECORDS

CASING RECORD

FORMATION	CONTENT	FROM	TO	SIZE	PUT IN	PULLED OUT
				5 1/2"	3833'	2741.75'
				8 5/8"	175'	

Describe in detail the manner in which the well was plugged, indicating where the mud fluid was placed and the method or methods used in introducing it into the hole. If cement or other plugs were used, state the character of same and depth placed, from _____ feet to _____ feet for each plug set.

Made bottom hole plug back with sand to 3600', mixed and ran 5 sacks cement thru dump bailer.

Pulled pipe to 1325', pumped in 250 sacks gel.

Pulled pipe to 1000', pumped in 100 sacks cement

Pulled pipe to 180' - pumped in 20 sacks cement. Set bridge at 35', mixed and ran 10 sacks cement to base of cellar.

RECEIVED
AUG 17 1967
CONSERVATION DIVISION
WICHITA, KANSAS

(If additional description is necessary, use BACK of this sheet)

Name of Plugging Contractor Great Bend, Kansas Southwest Casing Pulling Co., Inc.
Address _____

STATE OF Kansas, COUNTY OF Barton, ss.

Southwest Casing Pulling Co., Inc. (employee of owner) or (owner or operator) of the above-described well, being first duly sworn on oath, says: That I have knowledge of the facts, statements, and matters herein contained and the log of the above-described well as filed and that the same are true and correct. So help me God.

(Signature) W. C. Spencer Sec
Box 364, Great Bend, Kansas
(Address)

SUBSCRIBED AND SWORN to before me this 16 day of August, 19 67

My commission expires _____



William C. Spencer 1968

Notary Public.

15-065-00841-0000

W E L L L O G

OPERATOR D. G. Hansen

SEC. 7-10-21W

WELL NAME McElroy #1

LOC. SE SE SE

TOTAL DEPTH 3842'

COUNTY Graham

COMP. April 15, 1959

COMP. April 24, 1959

STATE Kansas

RIG NO. 1

ELEVATION 2297' K.B.

CASINO: Ran 175' (9 jts.) 8-5/8" OD Surface Casing.

PRODUCTION: Producing

Set 5-1/2" OD Casing @3834' (120 jts.)

All measurements taken from the top of rotary bushing.

FROM	TO	FORMATION	DEVIATION FROM VERTICAL	REMARKS:
0	175	Sand-Shale		
175	1780	Shale-Sand		
1780	1817	Anhydrite		
1817	2100	Shale-Red Bed		
2100	2380	Shale-Shell		
2380	2640	Shale-Lime	0° - 2500	
2640	2955	Lime-Shale	0° - 2750	
2955	3085	Shale-Lime	0° - 3000	
3085	3590	Lime-Shale	0° - 3250	DST 3569-3590'
3590	3728	Lime		DST 3612-3625'
3728	3760	Lime-Shale		DST 3689-3728'
3760	3775	Lime		DST 3728-3760'
3775	3842	Lime-Shale		DST 3833-3842'
3842	3842	Total Depth		

RECEIVED
STATE OF KANSAS COMMISSION

JUL 31 1967

CONSERVATION DIVISION
Wichita, Kansas

STATE OF KANSAS

COUNTY OF SEDGWICK

SS.

The undersigned hereby certifies that to the best of his knowledge and belief, the above facts are true and correct.

C-G DRILLING CO.

By

G. F. Galloway

TESTED, AND SWORN TO, BEFORE ME, THIS 28th day of April, 1959.

My commission expires:
May 22, 1959

Vicky Jacobs - Notary public