

15-065-00164-0000

STATE OF KANSAS  
STATE CORPORATION COMMISSION


WELL PLUGGING RECORD

OR  
FORMATION PLUGGING RECORD

Give All Information Completely  
Make Required Affidavit  
Mail or Deliver Report to:  
Conservation Division  
State Corporation Commission  
800 Bitting Building  
Wichita, Kansas

Strike out upper line  
when reporting plug-  
ging off formations.

NORTH

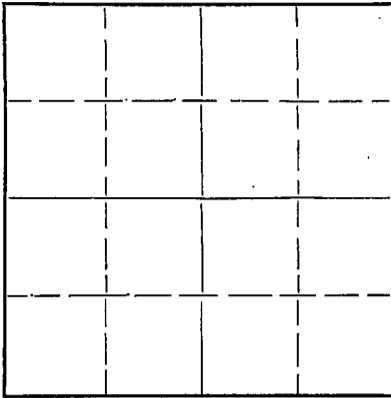

Locate well correctly on above  
Section Plat

Graham County. Sec. 7 Twp. 10 Rge. (E) 21 (W)  
Location as "NE 1/4 NW 1/4 SW 1/4" or footage from lines NW NW NE  
Lease Owner R. W. Rine Drilling Company  
Lease Name McClellan Well No. 1  
Office Address 320 Central Building Wichita, Kansas  
Character of Well (completed as Oil, Gas or Dry Hole) Dry Hole  
Date well completed May 12, 1949 19  
Application for plugging filed May 11, 1949 (telephone) 19  
Application for plugging approved May 11, 1949 (telephone) 19  
Plugging commenced May 11, 1949 4:00 P. M. 19  
Plugging completed May 11, 1949 6:00 P. M. 19  
Reason for abandonment of well or producing formation Dry Hole

If a producing well is abandoned, date of last production 19  
Was permission obtained from the Conservation Division or its agents before plugging was com-  
menced? Yes

Name of Conservation Agent who supervised plugging of this well Mr. C. D. Stough  
Producing formation None Depth to top Bottom Total Depth of Well 3950 Feet  
Show depth and thickness of all water, oil and gas formations.

OIL, GAS OR WATER RECORDS

CASING RECORD

Formation	Content	From	To	Size	Put In	Pulled Out
Water Sand		0	40	8-5/8"		

Describe in detail the manner in which the well was plugged, indicating where the mud fluid was placed and the method or methods used in introducing it into the hole. If cement or other plugs were used, state the character of same and depth placed, from 0 feet to 165 feet for each plug set.

Heavy mud to 165' plug with 15 sacks cement. Mud to 30' plug and 10 sacks cement.

RECEIVED  
MAY 18 1949  
05-18-49  
STATION  
KANSAS

(If additional description is necessary, use BACK of this sheet)

Correspondence regarding this well should be addressed to R. W. Rine Drilling Company  
Address 320 Central Building Wichita, Kansas

STATE OF Kansas, COUNTY OF Sedgwick, ss.  
E. H. Sloyer (employee of owner) or (XXXXXX) of the above-described well,


being first duly sworn on oath, says: That I have knowledge of the facts, statements, and matters herein contained and the log of the above-described well as filed and that the same are true and correct. So help me God.

(Signature) E. H. Sloyer  
320 Central Building Wichita, Ks.  
(Address)

SUBSCRIBED AND SWORN to before me this 17th day of May, 1949  
R. M. Green  
Notary Public.

My commission expires December 29, 1952

22-2625 2-48-15M

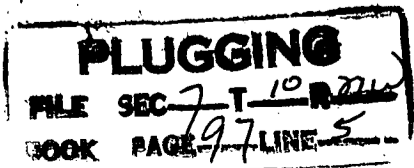

McClellan Well No. 1

NW NW NE  
Section 7-10-21  
Graham County, Kansas

Started: 4/30/49

Finished: 5/12/49

Contractor: R. W. Rine Drilling Company

Log

Clay, sand	0- 40
Shale	40-1235 8-5/8" w/ 150 sx. @ 173'
Sand, shale, shells	1235-1725
Shale, shells	1725-1795
Anhydrite	1795-1840
Shale, shells	1840-1925
Shale	1925-2285
Shale, lime	2285-2440
Shale, lime	2440-3025
Shale, shells	3025-3150
Shale, lime	3150-3480
Shale, shells	3480-3735
Lime, shale	3735-3845
Cherty lime, shale	3845-3895
Chert, lime	3895-3913
Lime, shale	3913-3950 T. D. 3950'
	D & A

Top Heebner Shale	3514'
Top K. C. Brown	3537'
Top K. C. Lansing	3554'
Marmaton	3840'
Top Conglomerate	3868'
Top Arbuckle	3912'

State of Kansas )  
County of Sedgwick) ss

I, E. H. Sloyer, do hereby certify that the above is a true and accurate log of the McClellan No. 1 Well in the NW NW NE of Section 7-10-21, Graham County, Kansas.

E. H. Sloyer  
Secretary

Subscribed and sworn to me this 17th day of May, 1949.

My commission expires Dec. 29, 1952

B. M. Green  
Notary Public

RECEIVED  
MAY 18 1949  
STATE CORPORATION  
COMMISSION  
KANSAS

PLUGGING  
FILE SEC 7-10-21  
BOOK PAGE 97 LINE 5