

15-065-03354-0001


STATE OF KANSAS
STATE CORPORATION COMMISSION
200 Colorado Derby Bldg.
Wichita, Kansas 67202

Form CP-4
Rev. 12-15-80

WELL PLUGGING RECORD

Give All Information Completely
Make Required Affidavit

COUNTY GRAHAM SEC. 6 TWP. 10 RGE. 21 E/W
Location as in quarters or footage from lines:
990 ft. NL, 990 ft. EL NW/4

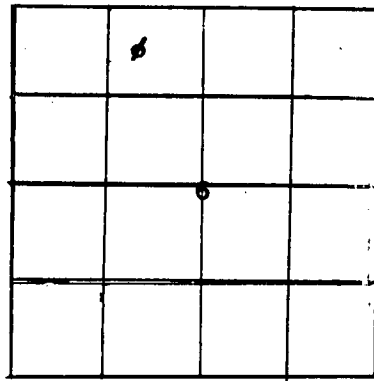

Locate Well
correctly on above
Section Platt.

Lease Owner Hellar Drilling Company, Inc.
Lease Name GUSTAFSON Well No. 3-2
Office Address 711 Petroleum Bldg., Wichita, Ks. 67202
Character of Well (Completed as Oil, Gas or Dry Hole): Oil
Date Well Completed 2/1/52
Application for plugging filed 4/15/83
Plugging commenced 5/4/83
Plugging completed 5/4/83
Reason for abandonment of well or producing formation _____

Depleted
Was permission obtained from the Conservation Division or it's
Agent's before plugging was commenced? Yes

Name of Conservation Agent who supervised plugging of this well Marion Schmidt
Producing formation Lans.-KC Depth to top 3525 bottom 3754 T.D. 3891
Show depth and thickness of all water, oil and gas formations.

OIL, GAS OR WATER RECORDS Casing Record

Formation	Content	From	To	Size	Put in	Pulled Out
<u>Lans.-KC</u>	<u>Water</u>	<u>3530</u>	<u>3534</u>	<u>8 5/8</u>	<u>128</u>	<u>None</u>
<u>Lans.-KC</u>	<u>Water</u>	<u>3458</u>	<u>3462</u>	<u>5 1/2</u>	<u>3890</u>	<u>None</u>
<u>Lans.-KC</u>	<u>Water</u>	<u>3341</u>	<u>3345</u>			


Describe in detail the manner in which the well was plugged, indicating where the mud fluid was placed and the method or methods used in introducing it into the hold. If cement or other plugs were used, state the character of same and depth placed, from _____ feet to _____ feet for each plug set.

Down annulus, mixed 2 sks hulls with 60 sks cement @ 400# max pressure and shut in.
Down 5 1/2"; mixed 10 sks cement, 2 sks hulls with 40 sks cement, 11 sks gel, 25 sks cement,
6 sks gel, released plug & mixed 90 sks cement @ 500# max pressure and shut in.

(If additional description is necessary, use BACK of this sheet)
Name of Plugging Contractor Allied Cementing Company, Inc.

STATE OF Kansas COUNTY OF Sedgwick, ss.
D. L. Hellar, Pres. Hellar Drilg. Co. Inc. (employee of owner) or (owner or operator) of the
above-described well, being first duly sworn on oath, says: That I have knowledge of the
facts, statements, and matters herein contained and the log of the above-described well as
filed and that the same are true and correct. So help me God.

(Signature) D. L. Hellar D. L. Hellar
711 Petroleum Bldg., Wichita, Ks. 67202
(Address)

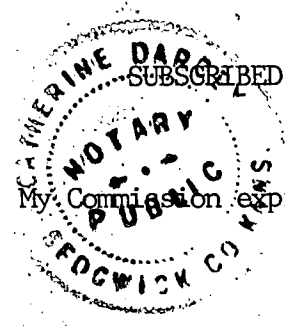

SUBSCRIBED AND SWORN TO before me this 7th day of June, 19 83

Catherine Darcey
Catherine Darcey - Notary Public.
STATE CORPORATION COMMISSION

JUN 08 1983