

15-065-01133-0000

STATE OF KANSAS  
STATE CORPORATION COMMISSION

Form CP-4


WELL PLUGGING RECORD

Give All Information Completely  
Make Required Affidavit  
Mail or Deliver Report to:  
Conservation Division  
State Corporation Commission  
211 No. Broadway  
Wichita, Kansas

Graham County. Sec. 6 Twp. 10 Rge. 21 (E) (W) X

Location as "NE/CNW/SW" or footage from lines NE NE NW  
Lease Owner D. G. Hansen Trust  
Lease Name Brown Estate Well No. #1  
Office Address Logan, Kansas  
Character of Well (completed as Oil, Gas or Dry Hole) \_\_\_\_\_  
Date well completed \_\_\_\_\_ 19\_\_\_\_  
Application for plugging filed \_\_\_\_\_ 19\_\_\_\_  
Application for plugging approved \_\_\_\_\_ 19\_\_\_\_  
Plugging commenced 6-10-70 19\_\_\_\_  
Plugging completed 6-16-70 19\_\_\_\_  
Reason for abandonment of well or producing formation \_\_\_\_\_

NORTH

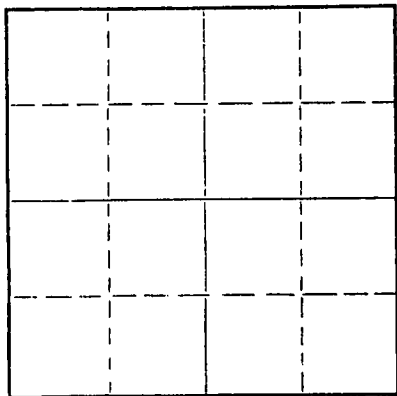

Locate well correctly on above  
Section Plat

If a producing well is abandoned, date of last production \_\_\_\_\_ 19\_\_\_\_  
Was permission obtained from the Conservation Division or its agents before plugging was commenced? \_\_\_\_\_

Name of Conservation Agent who supervised plugging of this well W. L. Nichols  
Producing formation \_\_\_\_\_ Depth to top \_\_\_\_\_ Bottom \_\_\_\_\_ Total Depth of Well 3867' Feet  
Show depth and thickness of all water, oil and gas formations.

OIL, GAS OR WATER RECORDS

CASING RECORD

FORMATION	CONTENT	FROM	TO	SIZE	PUT IN	PULLED OUT
				5 1/2"	3866'	718.26'
				8 5/8"	148'	

Describe in detail the manner in which the well was plugged, indicating where the mud fluid was placed and the method or methods used in introducing it into the hole. If cement or other plugs were used, state the character of same and depth placed, from \_\_\_\_\_ feet to \_\_\_\_\_ feet for each plug set.

Made bottom hole plug back with sand to 3550'. Mixed and ran 5 sacks cement thru dump bialer.  
Squeezed hole with 5 sacks hulls, followed with 90 sacks cement. Cement from 800' to 500' followed with 8 sacks gel. Gel from 500' to 200' followed with 35 sacks cement. Cement from 200' to 100', followed with 2 sacks gel. Gel from 100' to 30'. Displaced with 10 sacks cement. Cement from 30' to base of cellar.

RECEIVED  
STATE CORPORATION COMMISSION  
AUG 7 1970  
CONSERVATION DIVISION  
Wichita, Kansas

(If additional description is necessary, use BACK of this sheet)

Name of Plugging Contractor Southwest Casing Pulling Co.  
Address Box 364, Great Bend, Kansas

STATE OF Kansas, COUNTY OF Barton, ss.  
Southwest Casing Pulling Co. (employee of owner) or (owner or operator) of the above-described well, being first duly sworn on oath, says: That I have knowledge of the facts, statements, and matters herein contained and the log of the above-described well as filed and that the same are true and correct. So help me God.

(Signature) W. C. Spencer Sec  
Box 364, Great Bend, Kansas  
(Address)

Subscribed and sworn to before me this 6 day of August, 1970



My commission expires October 1972  
Sidney Miller Notary Public.

15-065-01133-0000

CONTRACTOR'S WELL LOG

Operator D-G Hansen Farm Name Brown # 1  
Location NE NE NW Sec. 6-10-21W  
Pool Name Beecher County Graham State Kansas  
Commencement Date 9-24-51 Completion Date 10-4-51

LOG OF WELL

Elevation 2290 R. B.  
All Measurements from the top of rotary bushing.

FROM	DEPTH	TO	FORMATION	DEVIATION FROM VERTICAL	REMARKS:
0		148			
148		710	Shale-Shells		
710		750	Shale-Sand Slt.		
750		1270	Shale-Sand	1000-00	
1270		1395	Sand		
1395		1450	Sand		
1450		1756	Shale-RedBed		
1756		1790	Anhydrite		
1790		2030	Shale	2000-00	
2030		2255	Shale		
2255		2355	Lime-Shale		
2355		2405	Lime-Shale		
2405		2470	Shale-Lime		
2470		2605	Lime-Shale	2500-00	
2605		2805	Lime-Shale		
2805		2920	Lime-Shale		
2920		2980	Lime-Shale		
2980		3090	Lime-Shale	3000-00	
3090		3195	Lime-Shale		
3195		3280	Lime-Shale		
3280		3325	Lime-Shale		
3325		3410	Lime-Shale		
3410		3470	Lime		
3470		3510	Lime-Shale	3500-00	
3510		3555	Lime		
3555		3599	Lime		
3599		3615	Lime		
3615		3672	Lime		
3672		3715	Lime		
3715		3770	Lime-Shale		
3770		3805	Lime-Shale		
3805		3859	Lime		
3859		3867	T.D.		

RECEIVED  
STATE CORPORATION COMMISSION  
JUN 12 1970  
CONSERVATION DIVISION  
Wichita, Kansas

CASING LEFT IN HOLE AFTER COMPLETION

Ran 148.80' ( 5 Jts.) 8 5/8" O D Casing  
Ran 3879.25' (123 jts.) 5 1/2" Casing

STATE OF KANSAS, COUNTY OF SEDGWICK ) SS

The undersigned certifies that to the best of his knowledge and belief, the above facts are true and correct.

C-G DRILLING CO.  
By R. A. Cook

Subscribed and sworn to before me this 5th day of October, 1951.

My commission expires: August 11, 1954

Alma Louise  
Notary Public