


15-065-00206-000

STATE OF KANSAS
STATE CORPORATION COMMISSION

WELL PLUGGING RECORD

Give All Information Completely
Make Required Affidavit
Mail or Deliver Report to:
Conservation Division
State Corporation Commission
800 Bitting Building
Wichita, Kansas

Graham County. Sec. 7 Twp. 10 Rge. (E) 21 (W)
Location as "NE/CNW $\frac{1}{4}$ SW $\frac{1}{4}$ " or footage from lines NW $\frac{1}{4}$ NW $\frac{1}{4}$ NW $\frac{1}{4}$
Lease Owner Barnett Drilling, Inc., et al
Lease Name McClellan Well No. 1
Office Address 417 First Nat'l. Bank Bldg., Wichita, Kansas.
Character of Well (completed as Oil, Gas or Dry Hole) Dry Hole
Date well completed December 27 19 50
Application for plugging filed December 27 19 50
Application for plugging approved December 27 19 50
Plugging commenced December 27 19 50
Plugging completed December 27 19 50
Reason for abandonment of well or producing formation Dry Hole

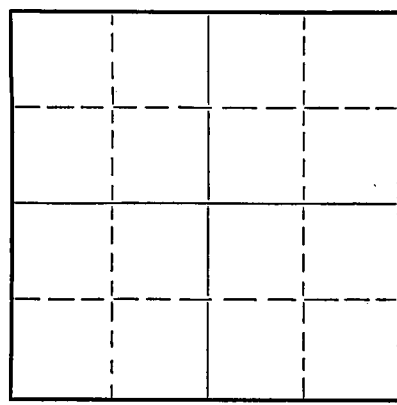

Locate well correctly on above
Section Plat

If a producing well is abandoned, date of last production - 19
Was permission obtained from the Conservation Division or its agents before plugging was commenced? Yes

Name of Conservation Agent who supervised plugging of this well Eldon Petty
Producing formation Depth to top Bottom Total Depth of Well 3957 Feet
Show depth and thickness of all water, oil and gas formations.

OIL, GAS OR WATER RECORDS

CASING RECORD

Formation	Content	From	To	Size	Put In	Pulled Out
Surface Casing				8 5/8"	164'	None

Describe in detail the manner in which the well was plugged, indicating where the mud fluid was placed and the method or methods used in introducing it into the hole. If cement or other plugs were used, state the character of same and depth placed, from feet to feet for each plug set.

Filled hole with heavy mud from 3957 feet to 164 feet. Set wooden plug at 164 feet and filled surface pipe with 1 sack of hulls and 15 sacks of cement to 117 feet. Filled surface pipe with heavy mud from 117 feet to 35 feet. Set wooden plug at 35 feet and filled surface pipe with 1/2 sack of hulls and 10 sacks of cement to bottom of cellar.

RECEIVED
STATE CORPORATION COMMISSION
JAN 13 1951 01-13-57
CONS.

(If additional description is necessary, use BACK of this sheet)
Correspondence regarding this well should be addressed to Barnett Drilling, Inc.
Address 417 First National Bank Building, Wichita, Kansas

STATE OF Kansas, COUNTY OF Sedgwick, ss.
W. R. Hunter (employee of owner) or (owner or operator) of the above-described well, being first duly sworn on oath, says: That I have knowledge of the facts, statements, and matters herein contained and the log of the above-described well as filed and that the same are true and correct. So help me God.
(Signature) [Signature]
First Nat'l Bank Bldg., Wichita, Kansas
(Address)

SUBSCRIBED AND SWORN to before me this 9th day of January 1951
[Signature] Notary Public.

PLUGGING
FILE SEC 2710 R 210
BOOK PAGE 58 LINE 17

BARNETT DRILLING, INC., ET AL

LOG OF McCLELLAN WELL NO. 1

NW $\frac{1}{4}$ NW $\frac{1}{4}$ NW $\frac{1}{4}$ SECTION 7-10S-21W, GRAHAM COUNTY, KANSAS

COMMENCED: December 11, 1950

COMPLETED: December 27, 1950

FORMATION	FROM	TO	REMARKS
Surface Clay	-0-	20	
Sand	20	30	
Shale and Shells	30	60	
Sand	60	70	
Shale and Shells	70	127	
Sand	127	154	
Shale and Shells	154	164	Set 8 5/8" Surface Casing at 164 ft., cemented with 152 sacks of cement.
Shale	164	375	
Shale and Shells	375	1305	
Sand	1305	1540	
Shale and Shells	1540	1800	
Anhydrite	1800	1840	
Shale and Shells	1840	2085	
Shale	2085	2165	
Shale and Lime	2165	2485	
Lime	2485	2610	
Lime and Shale	2610	3260	
Lime	3260	3310	
Lime and Shale	3310	3365	
Lime	3365	3862	
Lime and Shale	3862	3930	
Lime	3930	3957	
Total Depth		3957	Dry and Abandoned.

RECEIVED
STATE CORPORATION
JAN 13 1951

Certificate

I, W. R. Hunter, Vice-President of Barnett Drilling, Inc., hereby certify that to the best of my knowledge and belief the above is a true and correct log of the McClellan Well No. 1, located in the NW $\frac{1}{4}$ NW $\frac{1}{4}$ NW $\frac{1}{4}$ of Section 7-10S-21W, Graham County, Kansas.

W. R. Hunter

Subscribed and sworn to before me, a Notary Public in and for the County of Sedgwick, State of Kansas, this 9th day of January, 1951.

Delia Oliver
Notary Public.

My commission expires May 12, 1951.

PLUGGING
FILE SEC 7-10S-21W
BOOK PAGE 57 LINE 17