


STATE OF KANSAS
STATE CORPORATION COMMISSION

G. 3 All Information Completely
Make Required Affidavit
Mail or Deliver Report to:
Conservation Division
State Corporation Commission
212 No. Market
Wichita, Kansas

WELL PLUGGING RECORD

NORTH

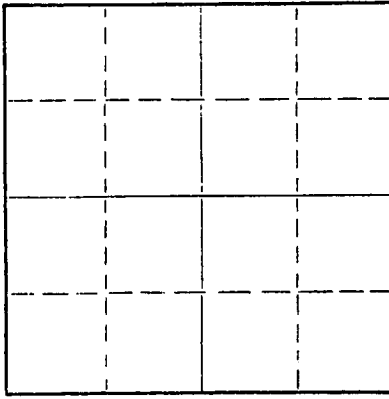

Locate well correctly on above
Section Plat

Graham County, Sec. 6 Twp. 10 Rge. (E) 21 (W)
Location as "NE/CNW/SW" or footage from lines
Lease Owner Specter Pipe & Supply, Inc. SENESE
Lease Name Germany Well No. 2
Office Address Box 169, Russell, Kansas
Character of Well (completed as Oil, Gas or Dry Hole) oil
Date well completed 8-11-53 19
Application for plugging filed 6-16-68 19
Application for plugging approved 6-17-68 19
Plugging commenced 7-10-68 19
Plugging completed 7-15-68 19
Reason for abandonment of well or producing formation Depleted

If a producing well is abandoned, date of last production _____ 19
Was permission obtained from the Conservation Division or its agents before plugging was commenced? yes Yes

Name of Conservation Agent who supervised plugging of this well Gilbert Leiker
Producing formation arbuckle Depth to top 3884' Bottom 3885' Total Depth of Well 3890 Feet
Show depth and thickness of all water, oil and gas formations.

OIL, GAS OR WATER RECORDS

CASING RECORD

FORMATION	CONTENT	FROM	TO	SIZE	PUT IN	PULLED OUT
				8 5/8"	233'	none
				5 1/2"	3885'	517.60'

Describe in detail the manner in which the well was plugged, indicating where the mud fluid was placed and the method or methods used in introducing it into the hole. If cement or other plugs were used, state the character of same and depth placed, from _____ feet to _____ feet for each plug set.

Plugged back to 3500 ft with sand
5 sacks cement
5 sacks hulls
35 sacks mud
130 sacks cement to top

RECEIVED
STATE CORPORATION COMMISSION
JUL 29 1968
CONSERVATION DIVISION
Wichita, Kansas

(If additional description is necessary, use BACK of this sheet)

Name of Plugging Contractor Lynch Casing Pulling Co.
Address RR#4 Great Bend, Kansas

STATE OF Kansas COUNTY OF Russell, ss.
Specter Pipe & Supply, Inc. (employee of owner) or (owner or operator) of the above-described well, being first duly sworn on oath, says: That I have knowledge of the facts, statements, and matters herein contained and the log of the above-described well as filed and that the same are true and correct. So help me Gpd.

(Signature) [Signature]
Russell, Kansas (Address)

SUBSCRIBED AND SWORN to before me this 25th day of July, 19 68

My commission expires May 21, 1971

Wilma M. Lindahl
Notary Public.

15-065-01127-0000


WELL LOG BUREAU - KANSAS GEOLOGICAL SOCIETY
308 East Murdock, Wichita, Kansas

Company: SUNRAY OIL CORPORATION
Farm: Germany No. 2

SEC. 6 T. 10 R. 21W
SE NE NE

Total Depth. 3890
Comm. 7-29-53 Comp. 8-11-53
Shot or Treated.
Contractor.
Issued. 9-26-53

County: Graham KANSAS

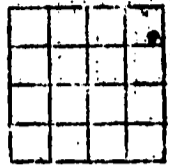

Elevation: 2311'

Production. Pmp. 240 BOPD NW.

Figures indicate Bottom of Formations.

sand	30
sand, shale & shells	205
shale & shells	235
shale	585
shale, shells, redbed	907
sand	1107
shale & sand	1520
shale & red bed	1791
anhydrite	1831
shale & shells	2200
shale & lime	2245
shale, shells & lime	2340
lime & shale	3514
lime	3739
lime & shale	3888 RTD
lime & shale	3890
Total Depth	

Tops:	
Topeka	3306
Heebner	3491
Toronto	3515
Lansing-K. C.	3530
Marmanton	3808
Conglomerate	3818
Simpson	3869
Arbuckle	3884

RECEIVED
STATE CORPORATION COMMISSION
JUN 17 1968
CONSERVATION DIVISION
Wichita, Kansas