


STATE OF KANSAS
STATE CORPORATION COMMISSION

Give All Information Completely
Make Required Affidavit
Mail or Deliver Report to:
Conservation Division
State Corporation Commission
212 No. Market
Wichita, Kansas

WELL PLUGGING RECORD

NORTH

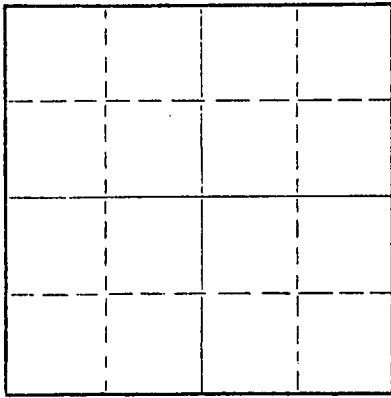

Locate well correctly on above
Section Plat

Graham County. Sec. 6 Twp. 10 Rge. (E) 21(W)
Location as "NE/CNW%SW%" or footage from lines NW SE NE
Lease Owner Specter Pipe & Supply, Inc.
Lease Name Germany Well No. 1
Office Address Box 169, Russell, Kansas
Character of Well (completed as Oil, Gas or Dry Hole) oil
Date well completed 6-7-53 19
Application for plugging filed 6-16-68 19
Application for plugging approved 6-17-68 19
Plugging commenced 7-9 19 68
Plugging completed 7-15 19 68
Reason for abandonment of well or producing formation Depleted

If a producing well is abandoned, date of last production _____ 19____
Was permission obtained from the Conservation Division or its agents before plugging was commenced? Yes

Name of Conservation Agent who supervised plugging of this well Gilbert Leiker
Producing formation arbuckle Depth to top 3877' Bottom 3878' Total Depth of Well 3882 Feet
Show depth and thickness of all water, oil and gas formations.

OIL, GAS OR WATER RECORDS

CASING RECORD

| FORMATION | CONTENT | FROM | TO | SIZE | PUT IN | PULLED OUT |
|-----------|---------|------|----|--------|--------|------------|
| | | | | 8" | 209' | none |
| | | | | 5 1/2" | 3878' | 825.47' |
| | | | | | | |
| | | | | | | |
| | | | | | | |
| | | | | | | |
| | | | | | | |

Describe in detail the manner in which the well was plugged, indicating where the mud fluid was placed and the method or methods used in introducing it into the hole. If cement or other plugs were used, state the character of same and depth placed, from _____ feet to _____ feet for each plug set.

Plugged back to 3500 ft with sand
5 sacks cement
5 sacks hulls
35 sacks mud
130 sacks cement to top

RECEIVED
STATE CORPORATION COMMISSION
JUL 29 1968
CONSERVATION DIVISION
Wichita, Kansas

(If additional description is necessary, use BACK of this sheet)
Name of Plugging Contractor Lynch Casing Pulling Co.
Address RR#4 Great Bend, Kansas

STATE OF Kansas COUNTY OF Russell, ss.
Specter Pipe & Supply, Inc. (employee of owner) or (owner or operator) of the above-described well, being first duly sworn on oath, says: That I have knowledge of the facts, statements, and matters herein contained and the log of the above-described well as filed and that the same are true and correct. So help me God.

(Signature) Morton Specter
Russell, Kansas
(Address)

SUBSCRIBED AND SWORN to before me this 25th day of July, 1968

My commission expires May 21, 1971
Notary Public.

15-065-01706-0000


WELL LOG BUREAU--KANSAS GEOLOGICAL SOCIETY
508 East Murdock, Wichita, Kansas

Company- SUNRAY OIL CORPORATION
Farm- Germany No. 1

SEC. 6 T. 10 R. 21W
NW SE NE

Total Depth. 3882
Comm. 5-25-53 Comp. 6-7-53
Shot or Treated...
Contractor. Stickle Drilling Co.
Issued. 8-1-53

County Graham
KANSAS

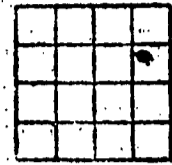

Elevation. 2293 RB

Production Pot. 149 BOPD
26 BWPD

CASING:

8" 209'
5" 3878'

Figures indicate Bottom of Formations.

| | |
|---------------------|------|
| clay & sand | 50 |
| sandy shale | 210 |
| shale & shells | 1245 |
| anhydrite 1745 to | 1785 |
| shale | 2000 |
| shale & shells | 2260 |
| shale & lime | 3560 |
| lime | 3642 |
| lime & shale | 3693 |
| lime | 3785 |
| lime & conglomerate | 3845 |
| conglomerate | 3882 |
| Total Depth | |

| | |
|--------------|------|
| TOPS: | |
| Toronto | 3501 |
| Lansing | 3516 |
| Base KC | 3747 |
| Marmaton | 3804 |
| Conglomerate | 3843 |
| Simpson | 3862 |
| Arbuckle | 3877 |

RECEIVED
STATE CORPORATION COMMISSION
JUN 17 1968
CONSERVATION DIVISION
Wichita, Kansas