

15-065-01712-0000

STATE OF KANSAS
STATE CORPORATION COMMISSION

Form CP-4


Give All Information Completely
Make Required Affidavit
Mail or Deliver Report to:
Conservation Division
State Corporation Commission
212 No. Market
Wichita, Kansas

WELL PLUGGING RECORD

GRAHAM County. Sec. 10 Twp. 10S Rge. 21 (EX) (W)

Location as "NE/CNWxSWx" or footage from lines NW NW NE
Lease Owner UNION TEXAS PETROLEUM
Lease Name BARTOS Well No. 3
Office Address 1740 BROADWAY, SUITE 400 DENVER, COLORADO
Character of Well (completed as Oil, Gas or Dry Hole) OIL
Date well completed 19
Application for plugging filed 19
Application for plugging approved NO DATE SHOWN 19
Plugging commenced APRIL 20 19 67
Plugging completed APRIL 24 19 67
Reason for abandonment of well or producing formation DEPLETED

NORTH

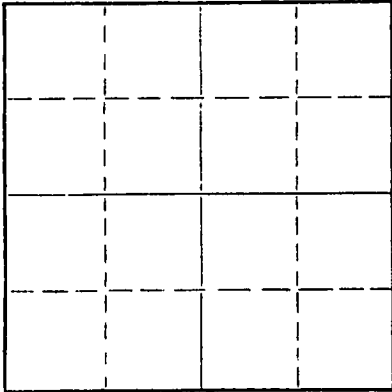

Locate well correctly on above
Section Plat

If a producing well is abandoned, date of last production 19
Was permission obtained from the Conservation Division or its agents before plugging was commenced? YES

Name of Conservation Agent who supervised plugging of this well W. L. NICHOLS
Producing formation Depth to top Bottom Total Depth of Well 3842' Feet
Show depth and thickness of all water, oil and gas formations.

OIL, GAS OR WATER RECORDS

CASING RECORD

FORMATION	CONTENT	FROM	TO	SIZE	PUT IN	PULLED OUT
				8-5/8"	259'	none
				5-1/2"	3842'	817.58'

Describe in detail the manner in which the well was plugged, indicating where the mud fluid was placed and the method or methods used in introducing it into the hole. If cement or other plugs were used, state the character of same and depth placed, from feet to feet for each plug set.

3842' - 3600' - plug
3600' - 3575' - sand
3575' - 3535' - 5 sacks cement
3535' - 225' - pumped 50 sacks jel mud & 6 sacks of hulls
225' - base - pumped 75 sacks cement

MAY 2 1967
15-065-01-67
Conservation Division

(If additional description is necessary, use BACK of this sheet)

Name of Plugging Contractor SANTA-FE PIPE & SUPPLY, INC.,
Address BOX 562, GREAT BEND, KANSAS

STATE OF KANSAS, COUNTY OF BARTON, ss.
T. L. NUTT (employee of owner) or (owner) of the above-described

well, being first duly sworn on oath, says: That I have knowledge of the facts, statements, and matters herein contained and the log of the above-described well as filed and that the same are true and correct. So help me God.

(Signature) [Signature]

BOX 562, GREAT BEND, KANSAS
(Address)

SUBSCRIBED AND SWORN to before me this 29 day of APRIL, 1967

[Signature] Notary Public.

My commission expires JULY 31, 1970

LOCATION: NW $\frac{1}{4}$, NW $\frac{1}{4}$, NE $\frac{1}{4}$ Sec. 10-10S-21W
Graham County, Kansas

OPERATOR: Anderson-Prichard Oil Corp.

CONTRACTOR: Birmingham-Bartlett Drilling Co.

SURFACE CASING: Ran 12 jts., 262.79' 8-5/8" 28.55#
casing cemented at 259' with 175 sacks
cement and 2 c.c.

OIL STRING: Ran 10 $\frac{1}{2}$ jts., 3845' 5 $\frac{1}{2}$ " 14# casing
with 125 sacks bulk cement.

L O G

(Figures indicate bottom of formation)

0 to 258	Surface
850	Shale
930	Sand and shale
1300	Shale
1490	Sand
1535	Shale
1764	Shale and red bed
1805	Anhydrite
2405	Shale and shells
2800	Shale and lime
3135	Shale
3470	Shale and lime
3793	Lime
3825	Conglomerate
3842	Lime
3842	Total Depth

The undersigned Richard Hindery of the Birmingham-Bartlett Drilling Co. hereby certifies that the above is a true and correct log of the formations encountered in drilling the Bartos #3 well as shown on the daily drilling reports.

BIRMINGHAM-BARTLETT DRILLING CO.

BY Richard Hindery

Subscribed and sworn before me
this 10th day of January, 1951.

Virian J. Singer
Notary Public

My commission expires November 29, 1954.

RECEIVED
STATE CORPORATION COMMISSION

MAR 17 1957

CONSERVATION DIVISION
Wichita, Kansas