


STATE OF KANSAS  
STATE CORPORATION COMMISSION

15-065-01716-0000

Give All Information Completely  
Make Required Affidavit  
Mail or Deliver Report to:  
Conservation Division  
State Corporation Commission  
212 North Market, Insurance Bldg.  
Wichita, Kansas

WELL PLUGGING RECORD

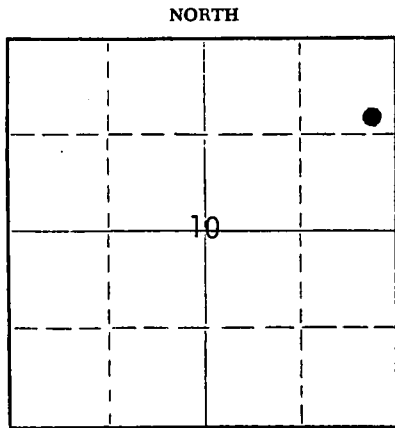

Locate well correctly on above Section Plat

Graham County, Sec. 10 Twp. 10 Rge. -- (E) 21 (W)  
Location as "NE/CNW/SW" or footage from lines SE NE NE  
Lease Owner Rocket-Schusterman Oil Account (Samson Resources Oper. 5463)  
Lease Name Bartos Well No. 7  
Office Address 2700 First National Tower, Tulsa, OK 74103  
Character of Well (completed as Oil, Gas or Dry Hole) Oil  
Date well completed September 20 19 81  
Application for plugging filed December 5 19 82  
Application for plugging approved December 14 19 82  
Plugging commenced March 18 19 83  
Plugging completed March 18 19 83  
Reason for abandonment of well or producing formation Dry

If a producing well is abandoned, date of last production No record 19       
Was permission obtained from the Conservation Division or its agents before plugging was commenced? Yes

Name of Conservation Agent who supervised plugging of this well Mr. Carl Goodrow  
Producing formation Arbuckle Depth to top 3836 Bottom 3851 Total Depth of Well 3851 Feet  
Show depth and thickness of all water, oil and gas formations.

OIL, GAS OR WATER RECORDS

CASING RECORD

FORMATION	CONTENT	FROM	TO	SIZE	PUT IN	PULLED OUT
Arbuckle	Oil	3836	3851	5 1/2"	3835	None

Describe in detail the manner in which the well was plugged, indicating where the mud fluid was placed and the method or methods used in introducing it into the hole. If cement or other plugs were used, state the character of same and depth placed, from Surface feet to 3000 feet for each plug set.

Pumped 10 sacks of cement mixed with 2 sacks of Hulls, followed by 20 sacks of Gel and 100 sacks of cement. All cement 50-50 Poz mix with 6% Gel and 3% CaCl. Pumped 10 sacks of cement down 8-5/8" to 5 1/2" casing annulus at 300 psi shut in pressure at 10:15 A.M. Top of cement in 5 1/2" stopped at 500 feet from surface, then dumped 2 yards of Redi-Mix concrete and filled to surface. Well plugged and abandoned.

(If additional description is necessary, use BACK of this sheet)

Name of Plugging Contractor Samson Resources Company (Oper. License #5463 for Rocket-Schusterman O.A.)  
Address 2700 First National Tower, Tulsa, OK 74103

STATE OF Oklahoma, COUNTY OF Tulsa, ss.  
R. J. Davis, Employee of Owner (employee of owner) or (owner or operator) of the above-described well, being first duly sworn on oath, says: That I have knowledge of the facts, statements, and matters herein contained and the log of the above-described well as filed and that the same are true and correct. So help me God.

(Signature) R. J. Davis  
2700 First National Tower, Tulsa, OK 74103  
(Address)

SUBSCRIBED AND SWORN TO before me this 24th day of March, 19 83

My commission expires Sept. 24, 1985

Alonza Ray Yarbrough  
Notary Public.



RECEIVED  
STATE CORPORATION COMMISSION

MAR 28 1983

CONSERVATION DIVISION  
Wichita, Kansas

