


Give All Information Completely
Make Required Affidavit
Mail or Deliver Report to:
Conservation Division
State Corporation Commission
211 No. Broadway
Wichita, Kansas

WELL PLUGGING RECORD

NORTH

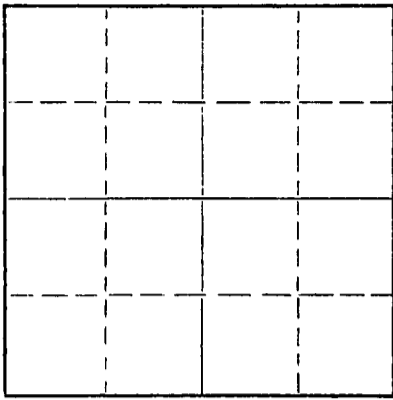

Locate well correctly on above
Section Plat

Graham County, Sec. 10 Twp. 10 Rge. (E) 21(W)
Location as "NE/CNW/SW" or footage from lines NE NW SE
Lease Owner Jones, Shelburne & Farmer, Inc.
Lease Name Mc INTIRE Well No. 5
Office Address Russell, Kansas
Character of Well (completed as Oil, Gas or Dry Hole) Dry
Date well completed 3-24 19 56
Application for plugging filed 3-24 19 56
Application for plugging approved 3-24 19 56
Plugging commenced 3-24 19 56
Plugging completed 3-24 19 56
Reason for abandonment of well or producing formation Dry

If a producing well is abandoned, date of last production 19
Was permission obtained from the Conservation Division or its agents before plugging was commenced? Yes

Name of Conservation Agent who supervised plugging of this well Eldon Petty
Producing formation Depth to top Bottom Total Depth of Well 3843 Feet
Show depth and thickness of all water, oil and gas formations.

OIL, GAS OR WATER RECORDS

CASING RECORD

FORMATION	CONTENT	FROM	TO	SIZE	PUT IN	PULLED OUT
				8-5/8"	159'	None

Describe in detail the manner in which the well was plugged, indicating where the mud fluid was placed and the method or methods used in introducing it into the hole. If cement or other plugs were used, state the character of same and depth placed, from feet to feet for each plug set.

- Filled hole with heavy mud
- Pushed plug to 150'
- Dumped 1/2 sack hulls on top of plug
- Mixed 15 sacks cement and dumped on top of hulls
- Filled hole to top
- Pushed plug to 40'
- Dumped in 1/2 sack hulls
- Mixed 10 sacks cement and filled hole to top with same.

(If additional description is necessary, use BACK of this sheet)
Name of Plugging Contractor Jones, Shelburne & Farmer, Inc.
Address Russell, Kansas

STATE OF Kansas COUNTY OF Russell, ss.
JOHN O. FARMER (~~proprietor~~) or (owner or operator) of the above-described well, being first duly sworn on oath, says: That I have knowledge of the facts, statements, and matters herein contained and the log of the above-described well as filed and that the same are true and correct. So help me God.
(Signature) John O. Farmer
Russell, Kansas
(Address)


SUBSCRIBED AND SWORN TO before me this 29th day of March, 19 56

Lucille Kennedy
Notary Public.

My commission expires October 11, 1958

PLUGGING
FILE SEC 10 T 10 R 21W
BOOK PAGE 49 LINE 9

03-30-56

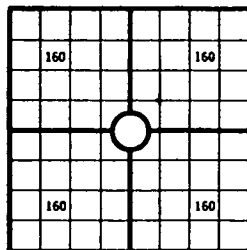OPERATOR Jones, Shelburne & Farmer, Inc.ADDRESS Russell, Kansas640 Acres
N

Locate well correctly

COUNTY Graham SEC. 10 TWP. 10 RGE 21
 COMPANY OPERATING Jones, Shelburne & Farmer, Inc.
 OFFICE ADDRESS Russell, Kansas
 FARM NAME McIntire WELL NO. #5
 DRILLING STARTED 3-13, 1956 DRILLING FINISHED 3-23, 1956
 DATE OF FIRST PRODUCTION _____ COMPLETED _____
 WELL LOCATED NE 1/4 NW 1/4 SE 1/4, North of South
 Line and _____ ft. East of West Line of Quarter Section
 Elevation (Relative to sea level) DERRICK FLOOR 2264 GROUND 2266
 CHARACTER OF WELL (Oil, gas or dryhole) dry

OIL OR GAS SANDS OR ZONES

Name	From	To	Name	From	To
1			4		
2			5		
3			6		

Perforating Record If Any

Shot Record

Formation	From	To	No. of Shots	Formation	From	To	Size of Shot

CASING RECORD

Amount Set								Amount Pulled		Packer Record	
Size	Wt.	Thds.	Make	Ft.	In.	Ft.	In.	Size	Length	Depth Set	Make
8	5/8			189							

Liner Record: Amount _____ Kind _____ Top _____ Bottom _____

CEMENTING AND MUDDING

Size	Amount Set		Sacks Cement	Chemical		Method of Cementing	Amount	Mudding Method	Results (See Note)
	Ft.	In.		Gal.	Make				
8	5/8	159	-	125					

Note: What method was used to protect sands if outer strings were pulled? _____

NOTE: Were bottom hole plugs used? _____ If so, state kind, depth set and results obtained _____

TOOLS USED

Rotary Tools were used from _____ feet to _____ Cable tools were used from _____ feet to _____ feet, and from _____ feet to _____ feet, and from _____ feet to _____ feet

Type Rig _____

INITIAL PRODUCTION TEST

Describe initial test: whether by flow through tubing or casing or by pumping _____

Amount of Oil Production _____ bbls. Size of choke, if any _____ Length of test _____ Water

Production _____ bbls. Gravity of oil _____ Type of Pump if pump is used, describe _____

FORMATION RECORD

Give detailed description and thickness of all formations drilled through, contents of sand, whether dry, water, oil or gas.

Formation	Top	Bottom	Formation	Top	Bottom
Surface	0	159			
Shale	159	860			
Shale & Sand	860	1685			
Shale	1685	1741			
Anhydrite	1741	1775			
Shale & Shells	1775	2360			
Lime & Shale	2360	3825			
Cong. Shale & Arb.	3825	3840			
Arbuckle	3840	3843			
T. D.		3843			
TOPS:					
Elevation			2266		RB
Anhydrite			1741		
Heebner			3477		
Toronto			3503		
Lansing			3518		
B. K. C.			3745		
Conglomerate			3796		
Simpson			3836		
Arbuckle			3838		
T. D.			3843		
D. & A.					

PLUGGING
 PER SEC-10-TWP-10-R-21W
 BOOK PAGE 19 LINE 9

I, the undersigned, being first duly sworn upon oath, state that this well record is true, correct and complete according to the records of this office and to the best of my knowledge and belief.

John D. Farmer
 Name and title of representative of company

Subscribed and sworn to before me this 28th day of March, 19 56
 My Commission expires Oct. 11, 1958
W. J. [Signature]
 Notary Public

15-065-02366-0000

WELL NO. #5 COUNTY Graham

FARM NAME McIntire

SEC. 10 TWP. 10 RGE. 21