


WELL PLUGGING RECORD

Give All Information Completely  
Make Required Affidavit  
Mail or Deliver Report to:  
Conservation Division  
State Corporation Commission  
212 No. Market  
Wichita, Kansas

Graham County. Sec. 10 Twp. 10 Rge. (E) 21(W)  
Location as "NE/CNW/SW" or footage from lines NE-NE-~~10~~ SE/4  
Lease Owner C & E Oil Co.  
Lease Name C & E Intyre Well No. 2  
Office Address Box # 405, St. Bond, Kans.  
Character of Well (completed as Oil, Gas or Dry Hole) Dry Hole  
Date well completed Apr. Sept 25 1966  
Application for plugging filed Dec 5 1966  
Application for plugging approved Dec 5 1966  
Plugging commenced Jan 5 1967  
Plugging completed Jan 5 1967  
Reason for abandonment of well or producing formation Dry Hole

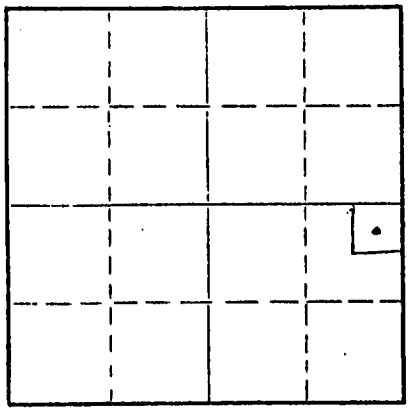

Locate well correctly on above Section Plat

If a producing well is abandoned, date of last production ✓ 19      
Was permission obtained from the Conservation Division or its agents before plugging was commenced? yes

Name of Conservation Agent who supervised plugging of this well W. L. Nichols  
Producing formation ✓ Depth to top ✓ Bottom ✓ Total Depth of Well 3781 Feet  
Show depth and thickness of all water, oil and gas formations.

OIL, GAS OR WATER RECORDS CASING RECORD

FORMATION	CONTENT	FROM	TO	SIZE	PUT IN	PULLED OUT

Describe in detail the manner in which the well was plugged, indicating where the mud fluid was placed and the method or methods used in introducing it into the hole. If cement or other plugs were used, state the character of same and depth placed, from      feet to      feet for each plug set.

Saddled Well back through 4 1/2 casing to 3700' and set 5 sacks cement with dump bailer. Palled 4 1/2" casing. Well left full of good rotary drilling mud. Ran 2 1/2" tubing to 550' and displaced 20 sacks cement through tubing. Palled tubing to 250' and displaced 20 sacks cement through tubing. Well left as potential fresh water well per request of land owner.

RECEIVED  
STATE CORPORATION COMMISSION

JAN 9 1967

CONSERVATION DIVISION  
Wichita, Kansas

(If additional description is necessary, use BACK of this sheet)  
Name of Plugging Contractor C & E Oil Co  
Address 1221 Sheridan, Great Bend, Kansas

STATE OF KANSAS COUNTY OF BARTON ss.  
Melvin C. Simpson (employee of owner) or (owner or operator) of the above-described well, being first duly sworn on oath, says: That I have knowledge of the facts, statements, and matters herein contained and the log of the above-described well as filed and that the same are true and correct. So help me God.

(Signature) Melvin C. Simpson  
1221 Sheridan Great Bend Kans (Address)

SUBSCRIBED AND SWORN TO before me this 5TH day of JANUARY, 1967  
Paul H. Schawe  
Notary Public.

My commission expires 9-29-69