


WELL PLUGGING RECORD

Give All Information Completely
Make Required Affidavit
Mail or Deliver Report to:
Conservation Division
State Corporation Commission
800 Bitting Building
Wichita, Kansas

NORTH

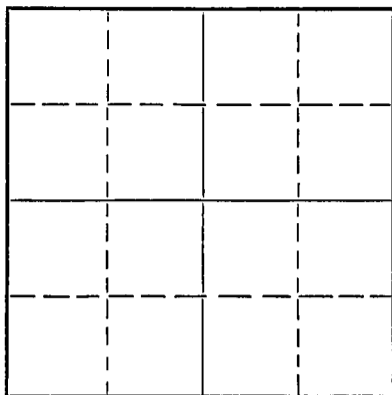

Locate well correctly on above
Section Plat

Graham County. Sec. 10 Twp. 10S Rge. (E) 21W (W)
Location as "NE/CNW $\frac{1}{4}$ /SW $\frac{1}{4}$ " or footage from lines NE NE SE
Lease Owner Jones, Shelburne & Farmer, Inc.
Lease Name McIntire Well No. 2
Office Address Russell, Kansas
Character of Well (completed as Oil, Gas or Dry Hole) Dry hole
Date well completed 10-5 1951
Application for plugging filed 10-5 1951
Application for plugging approved 10-5 1951
Plugging commenced 10-5 1951
Plugging completed 10-5 1951
Reason for abandonment of well or producing formation Dry

If a producing well is abandoned, date of last production 19...
Was permission obtained from the Conservation Division or its agents before plugging was commenced? yes

Name of Conservation Agent who supervised plugging of this well Elden Petty
Producing formation Depth to top Bottom Total Depth of Well 3923 Feet
Show depth and thickness of all water, oil and gas formations.

OIL, GAS OR WATER RECORDS

CASING RECORD

Formation	Content	From	To	Size	Put In	Pulled Out

Describe in detail the manner in which the well was plugged, indicating where the mud fluid was placed and the method or methods used in introducing it into the hole. If cement or other plugs were used, state the character of same and depth placed, from feet to feet for each plug set.

1. Filled hole with heavy mud
2. Pushed Halliburton plug to 155'
3. 1/2 sack hulls dumped on top of plug
4. 15 sacks cement mixed and dumped on top of hulls
5. Second Halliburton plug pushed to 40'
6. 1/2 sack hulls dumped on top of plug
7. 10 sacks cement mixed and hole filled to top with same

10-09-51

(If additional description is necessary, use BACK of this sheet)

Name of Plugging Contractor Jones, Shelburne & Farmer, Inc.
Address Russell, Kansas

STATE OF KANSAS, COUNTY OF RUSSELL, ss.

John O. Farmer (employee of owner) or (owner or operator) of the above-described well, being first duly sworn on oath, says: That I have knowledge of the facts, statements, and matters herein contained and the log of the above-described well as filed and that the same are true and correct. So help me God.

(Signature) *John O. Farmer*


Russell, Kansas (Address)

SUBSCRIBED AND SWORN TO before me this 6th day of October, 1951.

Josephine E. Waag
Notary Public.

My commission expires February 19, 1955

PLUGGING
FILE 10-10-51
BOOK PAGE 14 UNIT 40

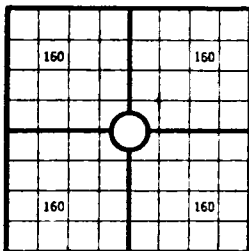OPERATOR Jones, Shelburne & Farmer, Inc.ADDRESS Russell, Kansas640 Acres
N

Locate well correctly

COUNTY Graham SEG 10 TWP 10S RGE 21W
 COMPANY OPERATING Jones, Shelburne & Farmer
 OFFICE ADDRESS Russell, Kansas
 FARM NAME McIntire WELL NO. 2
 DRILLING STARTED 7-22-51 DRILLING FINISHED 10-4-51
 DATE OF FIRST PRODUCTION _____ COMPLETED _____
 WELL LOCATED NE 1/4 NE 1/4 SE 1/4 North of South
 Line and _____ ft. East of West Line of Quarter Section
 Elevation (Relative to sea level) DERRICK FLOOR 2270 GROUND _____
 CHARACTER OF WELL (Oil, gas or dryhole) Dry hole

OIL OR GAS SANDS OR ZONES

Name	From	To	Name	From	To
1			4		
2			5		
3			6		

Perforating Record If Any

Shot Record

Formation	From	To	No. of Shots	Formation	From	To	Size of Shot

CASING RECORD

Amount Set								Amount Pulled		Packer Record	
Size	Wt.	Thds.	Make	Ft.	In.	Ft.	In.	Size	Length	Depth Set	Make
<u>8-3/8</u>				<u>160</u>				<u>100'</u>			

Liner Record: Amount _____ Kind _____ Top _____ Bottom _____
 CEMENTING AND MUDDING

Size	Amount Set		Sacks Cement	Chemical		Method of Cementing	Amount	Mudding Method	Results (See Note)
	Ft.	In.		Gal.	Make				
<u>8-5/8</u>			<u>100'</u>						

Note: What method was used to protect sands if outer strings were pulled? _____

NOTE: Were bottom hole plugs used? _____ If so, state kind, depth set and results obtained _____

TOOLS USED

Rotary Tools were used from _____ feet to _____ feet. Cable tools were used from _____ feet to _____ feet, and from _____ feet to _____ feet, and from _____ feet to _____ feet.

Type Rig _____

INITIAL PRODUCTION TEST

Describe initial test, whether by flow through tubing or casing or by pumping _____

Amount of Oil Production _____ bbls. Size of choke, if any _____ Length of test _____ Water

Production _____ bbls. Gravity of oil _____ Type of Pump if pump is used, describe _____

FORMATION RECORD

Give detailed description and thickness of all formations drilled through, contents of sand, whether dry, water, oil or gas.

Formation	Top	Bottom	Formation	Top	Bottom
Shale	0	270	Heebner	3484	
Shale shells & sand	220	1250	Lansing	3526	
Shale & shells	1250	1744	Base K.C.	3742	
Anhydrite	1744	1790	Harmotan	3764	
Red bed, shale & shells	1790	1920	Conglomerate	3799	
Shale & shells	1920	2340	Arbuckle	3781	
Lime & shale	2340	2725	T. D.	3923	
Shale & lime	2725	2825			
Lime & shale	2825	3570			
Lime	3570	3800			
Lime & shale	3800	3830			
Conglomerate	3830	3915			
Arbuckle	3915	3928			
Arbuckle	3928	3923			

I, the undersigned, being first duly sworn upon oath, state that this well record is true, correct and complete according to the records of this office and to the best of my knowledge and belief.

Arthur J. ...
 Vice President

8th Name and Title of representative of company _____

Subscribed and sworn to on _____ day of _____ 19 _____

My Commission expires _____ Notary Public.

15-065 - 30366 - 0000
 2776
 107
 11735V
 48
 11735V
 48

15-065 - 30366 - 0000
 FARM NAME _____ COUNTY _____ TWP _____ RGE _____