

STATE OF KANSAS
STATE CORPORATION COMMISSION


15-065-19205-0000

WELL PLUGGING RECORD

Give All Information Completely
Make Required Affidavit
Mail or Deliver Report to:
Conservation Division
State Corporation Commission
800 Bitting Building
Wichita, Kansas

Graham County, Sec. 10 Twp. 10S Rge. (E) 21 (W)
NE, NW, SE, N/2, N/2 SE

Location as "NE/CNW¹/₄SW¹/₄" or footage from lines
Lease Owner Jones, Shelburne & Farmer, Inc.
Lease Name McIntire Well No. 3
Office Address Russell, Kansas
Character of Well (completed as Oil, Gas or Dry Hole) Dry
Date well completed 12-12 1951
Application for plugging filed 12-12 1951
Application for plugging approved 12-12 1951
Plugging commenced 12-12 1951
Plugging completed 12-12 1951
Reason for abandonment of well or producing formation Dry

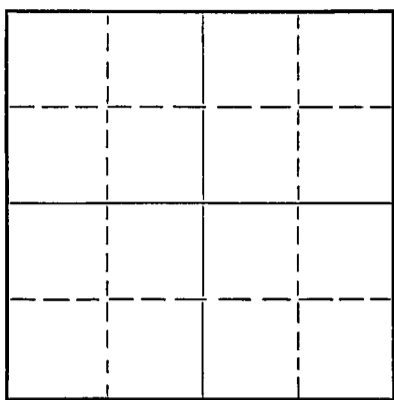

Locate well correctly on above
Section Plat

If a producing well is abandoned, date of last production Never Produced 19...
Was permission obtained from the Conservation Division or its agents before plugging was commenced? Yes

Name of Conservation Agent who supervised plugging of this well Eldon Petty
Producing formation Depth to top Bottom Total Depth of Well 3880 Feet
Show depth and thickness of all water, oil and gas formations.

OIL, GAS OR WATER RECORDS CASING RECORD

Formation	Content	From	To	Size	Put In	Pulled Out
				8 5/8"	165'	None

Describe in detail the manner in which the well was plugged, indicating where the mud fluid was placed and the method or methods used in introducing it into the hole. If cement or other plugs were used, state the character of same and depth placed, from feet to feet for each plug set.

1. Hole filled with heavy mud to 160'.
2. Halliburton plug pushed to 160'.
3. 1/2 sk hulls dumped on top of plug.
4. 15 sks cement mixed and spotted on top of hulls.
5. Hole filled to 40' with heavy mud.
6. 2nd Halliburton plug pushed to 40'.
7. 1/2 sk hulls dumped on top of plug.
8. 10 sks cement mixed and hole filled with sand.

12-19-51

(If additional description is necessary, use BACK of this sheet)

Name of Plugging Contractor Jones, Shelburne & Farmer, Inc.
Address Russell, Kansas

STATE OF Kansas, COUNTY OF Russell, ss.
John G. Farmer, Vice-President (employee of owner) or (owner or operator) of the above-described well,

being first duly sworn on oath, says: That I have knowledge of the facts, statements, and matters herein contained and the log of the above-described well as filed and that the same are true and correct. So help me God.

(Signature) *John G. Farmer*

(Address)

SUBSCRIBED AND SWORN to before me this 14th day of December, 1951.

Jerry S. Malala
Notary Public.

My commission expires October 24, 1955.

10 10 21W
137 13

OPERATOR Jones, Shelburne & Farmer, Inc.

ADDRESS Russell, Kansas

240 Acres
N

160		160
160		160

Locate well correctly.

COUNTY Graham SEC 10 TWP 10S RGE 21W
 COMPANY OPERATING Jones, Shelburne & Farmer, Inc.
 OFFICE ADDRESS Russell, Kansas
 FARM NAME McIntire WELL NO. 3
 DRILLING STARTED 11-30-51 DRILLING FINISHED 12-12-51
 DATE OF FIRST PRODUCTION LEVER CONCRETE PRODUCED
 WELL LOCATED: N 1/4 NE 1/4 SE 1/4 North of South
 Line and _____ ft. East of West Line of Quarter Section
 Elevation (Relative to sea level) DERRICK FLOOR 2279 GROUND _____
 CHARACTER OF WELL (Oil, gas or dryhole) Dry

OIL OR GAS SANDS OR ZONES

Name	From	To	Name	From	To
1			4		
2			5		
3			6		

Perforating Record If Any

Shot Record

Formation	From	To	No. of Shots	Formation	From	To	Size of Shot

CASING RECORD

Amount Set				Amount Pulled				Packer Record			
Size	Wt.	Thick.	Make	Pl.	In.	Pl.	In.	Size	Length	Depth Set	Make
5 7/8	24	8	165								

Liner Record: Amount _____ Kind _____ Top _____ Bottom _____

CEMENTING AND MUDDING

Amount Set			Chemical		Method of		Amount	Mudding	Results
Size	Pt.	Lb.	Gal.	Make	Cementing	Method			
5 7/8		165							

Note: What method was used to protect sands if outer strings were pulled?

NOTE: Were bottom hole plugs used? _____ If so, note kind, depth set and results obtained.

TOOLS USED

Rotary Tools were used from _____ feet to _____ Cable tools were used from _____ feet to _____
 _____ feet; and from _____ feet to _____ feet; and from _____ feet to _____ feet
 Type Rig _____

INITIAL PRODUCTION TEST

Describe initial test, whether by flow through tubing or casing or by pumping _____

Amount of Oil Production _____ bbls. Size of choke, if any _____ Length of test _____ Water

Production _____ bbls. Gravity of oil _____ Type of Pump if pump is used, describe _____

FORMATION RECORD

Give detailed description and thickness of all formations drilled through, contents of sand, whether dry, water, oil or gas.

Formation	Top	Bottom	Formation	Top	Bottom
Shale & Sand	•	1570	TOPS:		
Shale	1570	1750	Anhydrite ...	1750	
Anhydrite	1750	1795	Elevation ...	2281	
Shale	1795	1800	Heebner ...	3501	
Shale & Red Bed	1800	2095	Toronto ...	3530	
Shells			Lansing ...	3543	
Shale & Shells	2095	2280	Cong. ...	3795	
Shale & Lime	2280	2650	Arbuckle ...	3868	
Lime & Shale	2650	2895	T.D. ...	3880	
Shale & Lime	2895	3035			
Lime & Shale	3035	3230			
Shale & Lime	3230	3340			
Lime & Shale	3340	3470			
Shale & Lime	3470	3535			
Lime & Shale	3535	3620			
Lime	3620	3795			
Conglomerate	3795	3868			
Arbuckle	3868	3880			
T.D.	3880				

REC
STATE OF KANSAS

DEC 7 1951

FILE
BOOK PAGE 150-151

I, the undersigned, being first duly sworn upon oath, state that this well record is true, correct and complete according to the records of this office and to the best of my knowledge and belief.

John Farmer
 Name and title of representative of company
 Vice President

Subscribed and sworn to before me this 17 day of December 1951My Commission expires April, 1955
Jerry S. Robinson
 Notary Public

WELL NO. 3 COUNTY Graham SEC 10 TWP 10S RGE 21W FARM NAME McIntire 15-065-19205-0000