

15-065-02493-0000


STATE OF KANSAS  
STATE CORPORATION COMMISSION

WELL PLUGGING RECORD

Give All Information Completely  
Make Required Affidavit  
Mail or Deliver Report to:  
Conservation Division  
State Corporation Commission  
800 Bittling Building  
Wichita, Kansas

Graham County. Sec. 10 Twp. 10S Rge. (E) 21N(W)  
Location as "NE/CNW $\frac{1}{4}$ SW $\frac{1}{4}$ " or footage from lines S $\frac{1}{2}$  NE $\frac{1}{4}$  NE $\frac{1}{4}$   
Lease Owner Anderson-Prichard Oil Corporation  
Lease Name Bartos Well No. 2  
Office Address Box 142, Great Bend, Kansas  
Character of Well (completed as Oil, Gas or Dry Hole) Dry Hole  
Date well completed 10-3 19 50  
Application for plugging filed 10-3 19 50  
Application for plugging approved 10-3 19 50  
Plugging commenced 10-3 19 50  
Plugging completed 10-3 19 50  
Reason for abandonment of well or producing formation no oil encountered

NORTH

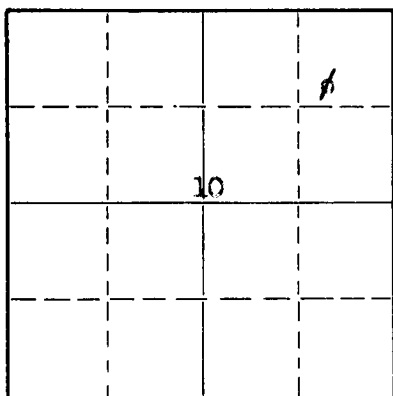

Locate well correctly on above  
Section Plat

If a producing well is abandoned, date of last production -- 19  
Was permission obtained from the Conservation Division or its agents before plugging was commenced? Yes

Name of Conservation Agent who supervised plugging of this well Eldon Petty  
Producing formation None produced Depth to top 394.9 Bottom 394.9 Total Depth of Well 394.9 Feet  
Show depth and thickness of all water, oil and gas formations  
Conglomerate section reached

OIL, GAS OR WATER RECORDS

CASING RECORD

Formation	Content	From	To	Size	Put In	Pulled Out
		0	250	10-3/4"	246'	None

Describe in detail the manner in which the well was plugged, indicating where the mud fluid was placed and the method or methods used in introducing it into the hole. If cement or other plugs were used, state the character of same and depth placed, from...feet to ...feet for each plug set.

Filled w/heavy mud to 240' Halliburton Plug at 240'  
20 sax of cement on top of plug. Filled w/heavy mud  
to 30'. Halliburton Plug at 30'. 10 sax cement on  
top plug to surface. Tied top plug with wire.

(If additional description is necessary, use BACK of this sheet)

Correspondence regarding this well should be addressed to Anderson-Prichard Oil Corporation  
Address c/o W. J. Dearen, Route 1, West 10th Street, Great Bend, Kansas

STATE OF KANSAS, COUNTY OF BARTON, ss.  
Gerald M. Dougherty (employee of owner) or (owner or operator) of the above-described well,  
being first duly sworn on oath, says: That I have knowledge of the facts, statements, and matters herein contained and the log of the above-described well as filed and that the same are true and correct. So help me God.

(Signature) Gerald M. Dougherty District Clerk  
Box 142, Great Bend, Kansas (Address)

SUBSCRIBED AND SWORN to before me this 11th day of October, 19 50.

My commission expires April 26, 1952

Ann M. Laudick Notary Public

PLUGGING  
FILE SEC 10 T 10 R 7 W 2  
BOOK PAGE 33 LINE 8

OCT 13 1950  
CONSERVATION DIVISION  
Wichita, Kansas

BARTOS #2 WELL

LOCATION:	SW $\frac{1}{4}$ NE $\frac{1}{4}$ NE $\frac{1}{4}$ Sec. 10-10S-21W Graham County, Kansas	SPUDED:	9-22-50
OPERATOR:	Anderson-Prichard Oil Corporation	COMPLETED:	10-3-50
CONTRACTOR:	Birmingham-Bartlett Drilling Co.		
SURFACE CASING:	10-3/4" casing cemented @ 246' with 175 sacks and 2 c.c.		
OIL STRING:	None - D & A		

L O G

(Figures indicate bottom of formation)

0 to 250	Surface
900	Shale & Sand
990	Sand & Shale
1322	Shale
1510	Sand
1650	Shale & Shells
1761	Shale & Red Bed
1798	Anhydrite
1890	Shale
2470	Shale & Shells
2710	Lime & Shale
2925	Shale & Shells
3165	Shale
3473	Shale & Lime
3800	Lime
3835	Lime & Conglomerate
3849	Lime, Shale & Conglomerate
3949	Conglomerate
3949	Total Depth

The undersigned, Richard Hindery, of the Birmingham-Bartlett Drilling Co. hereby certifies that the above is a true and correct log of the formations encountered in drilling the Bartos #2 well, as shown on the daily drilling reports.

BIRMINGHAM-BARTLETT DRILLING CO.

By Richard Hindery

Subscribed and sworn before me  
this 5th day of October, 1950.

Vivian J. Ginger  
Notary Public

My commission expires:  
November 29, 1950

