

STATE OF KANSAS  
STATE CORPORATION COMMISSION

WELL PLUGGING RECORD

Give All Information Completely  
Make Required Affidavit  
Mail or Deliver Report to:  
Conservation Division  
State Corporation Commission  
800 Bitting Building  
Wichita, Kansas

Graham County, Sec. 10 Twp. 10S Rge. 21 (W)

Location as "NE/CNW/SWK" or footage from lines NE NE SW

Lease Owner Jones, Shelburne & Farmer, Inc.

Lease Name Bartos Well No. 1

Office Address Russell, Kansas

Character of Well (completed as Oil, Gas or Dry Hole) Dry

Date well completed 5-30 1953

Application for plugging filed 5-30 1953

Application for plugging approved 5-30 1953

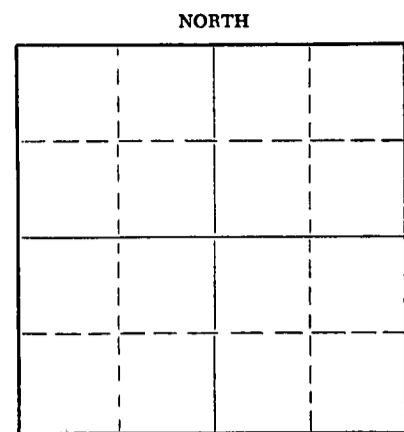
Plugging commenced 5-30 1953

Plugging completed 5-30 1953

Reason for abandonment of well or producing formation dry

If a producing well is abandoned, date of last production Never produced 19    

Was permission obtained from the Conservation Division or its agents before plugging was commenced? yes



Locate well correctly on above Section Plat

Name of Conservation Agent who supervised plugging of this well Elden Petty

Producing formation      Depth to top      Bottom      Total Depth of Well 3873 Feet

Show depth and thickness of all water, oil and gas formations.

OIL, GAS OR WATER RECORDS

CASING RECORD

FORMATION	CONTENT	FROM	TO	SIZE	PUT IN	PULLED OUT
				8 5/8	165	none

Describe in detail the manner in which the well was plugged, indicating where the mud fluid was placed and the method or methods used in introducing it into the hole. If cement or other plugs were used, state the character of same and depth placed, from      feet to      feet for each plug set.

1. Filled hole with heavy mud
2. Pushed plug to 160'
3. Dumped 1/2 sack hulls on top of plug
4. Mixed 15 sacks cement and dumped on top of hulls
5. Filled hole to top
6. Pushed plug to 40'
7. Dumped in 1/2 sack hulls
8. Mixed 10 sacks cement and filled hole to top with same

(If additional description is necessary, use BACK of this sheet)

Name of Plugging Contractor Jones, Shelburne & Farmer, Inc. 06-04-53

Address Russell, Kansas

STATE OF Kansas, COUNTY OF Russell, ss.

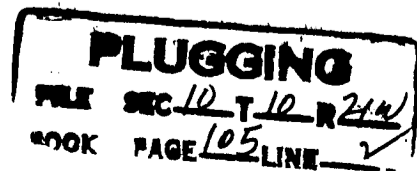
John O. Farmer (employee of owner) or (owner or operator) of the above-described well, being first duly sworn on oath, says: That I have knowledge of the facts, statements, and matters herein contained and the log of the above-described well as filed and that the same are true and correct. So help me God.

(Signature) John O. Farmer  
Russell, Kansas  
(Address)

SUBSCRIBED AND SWORN TO before me this 2nd day of June, 1953

Bonnie Berryhill  
Notary Public.

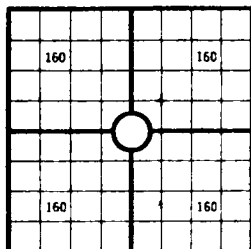
My commission expires April 23, 1956



OPERATOR Jones, Shelburne & Farmer, Inc.ADDRESS Russell, Kansas

## FORMATION RECORD

Give detailed description and thickness of all formations drilled through, contents of sand, whether dry, water, oil or gas.

640 Acres  
N

Locate well correctly

COUNTY Graham SEC 10 TWP 10S RGE 21W  
COMPANY OPERATING Jones, Shelburne & Farmer, Inc.OFFICE ADDRESS Russell, KansasFARM NAME Bartos WELL NO. 1DRILLING STARTED 5-19, 1953 DRILLING FINISHED 5-30, 1953

DATE OF FIRST PRODUCTION \_\_\_\_\_ COMPLETED \_\_\_\_\_

WELL LOCATED NE 1/4 NE 1/4 SW 1/4 North of South

Line and \_\_\_\_\_ ft. East of West Line of Quarter Section

Elevation (Relative to sea level) DERRICK FLOOR 2268 GROUND \_\_\_\_\_CHARACTER OF WELL (Oil, gas or dryhole) Dry

## OIL OR GAS SANDS OR ZONES

Name	From	To	Name	From	To
1			4		
2			5		
3			6		

## Perforating Record If Any

## Shot Record

Formation	From	To	No. of Shots	Formation	From	To	Size of Shot

## CASING RECORD

Amount Set								Amount Pulled		Packer Record	
Size	Wt.	Thds.	Make	Ft.	In.	Ft.	In.	Size	Length	Depth Set	Make
8 5/8	24	8	smls	165				none			

Liner Record: Amount \_\_\_\_\_ Kind \_\_\_\_\_ Top \_\_\_\_\_ Bottom \_\_\_\_\_

## CEMENTING AND MUDDING

Size	Amount Set		Sacks Cement	Chemical		Method of Cementing	Amount	Mudding Method	Results (See Note)
	Ft.	In.		Gal.	Make				
8 5/8	165		125						

Note: What method was used to protect sands if outer strings were pulled? \_\_\_\_\_

NOTE: Were bottom hole plugs used? \_\_\_\_\_ If so, state kind, depth set and results obtained \_\_\_\_\_

## TOOLS USED

Rotary Tools were used from \_\_\_\_\_ feet to \_\_\_\_\_ feet. Cable tools were used from \_\_\_\_\_ feet to \_\_\_\_\_ feet.

\_\_\_\_\_ and from \_\_\_\_\_ feet to \_\_\_\_\_ feet, and from \_\_\_\_\_ feet to \_\_\_\_\_ feet.

Type R \_\_\_\_\_

## INITIAL PRODUCTION TEST

Describe \_\_\_\_\_ whether by flow through tubing or casing or by pumping \_\_\_\_\_

Amount of Oil Production \_\_\_\_\_ bbls. Size of choke, if any \_\_\_\_\_ Length of test \_\_\_\_\_ Water

Production \_\_\_\_\_ bbls. Gravity of oil \_\_\_\_\_ Type of Pump if pump is used, describe \_\_\_\_\_

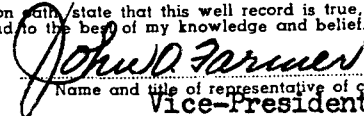
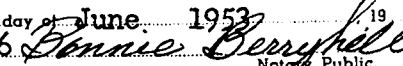
1 \_\_\_\_\_

Formation	Top	Bottom	Formation	Top	Bottom
Shale & sand	0	160			
Shale & shells	160	870			
Sand	870	980			
Shale & shells	980	1245			
Sand	1245	1390			
Shale & shells	1390	1747			
Anhydrite	1747	1789			
Shale & shells	1789	2320			
Shale & lime	2320	2470			
Lime & shale	2470	3520			
Lime	3520	3775			
Lime & shale	3775	3845			
Lime-shale, chert & Arbuckle	3845	3873			

TOPS:

Elevation 2268 R. B.  
Heebner 3487  
Toronto 3505  
Lansing 3528  
Arbuckle 3849  
T. D. 3873

I, the undersigned, being first duly sworn upon oath, state that this well record is true, correct and complete according to the records of this office and to the best of my knowledge and belief.


  
Name and title of representative of company  
Vice-President
Subscribed and sworn to before me this 3rd day of June, 1953  
My Commission expires April 23, 1956   
Notary Public.15-005-02587-0000  
WELL NO. 1  
COUNTY Graham  
SEC. 10  
TWP. 10S  
RGE. 21W  
FARM NAME Bartos
