

WELL PLUGGING RECORD 15-005-21839-0000

Give All Information Completely
Make Required Affidavit
Mail or Deliver Report to
Conservation Division
State Corporation Comm.
200 Colorado Derby Bldg.
202 W. 1st St.
Wichita, KS 67202

Graham County Sec. 10 Twp. 10 Rge. 21 ~~EW~~
Location as "NE/CNW/SW" or footage from lines _____
990' FNL 1320' FWL

Lease Owner Heartland Enterprises

Lease Name _____ Well No. #1

Office Address 253 F Street Phillipsburg, Ks 67661

Character of Well (Completed as Oil, Gas or Dry Hole) _____
Dry Hole

Date Well completed 8-22 1983

Application for plugging filed 8-22 1983

Application for plugging approved 8-22 1983

Plugging commenced 8-22 1983

Plugging completed 8-22 1983

Reason for abandonment of well or producing formation _____
NO COMMERCIAL PRODUCTION


If a producing well is abandoned, date of last production _____
19

Was permission obtained from the Conservation Division or its agents before plugging was commenced? Yes

Name of Conservation Agent who supervised plugging of this well Gil Balthazor

Producing formation _____ Depth to top _____ Bottom _____ Tl. Depth of Well _____

Show depth and thickness of all water, oil and gas formations.

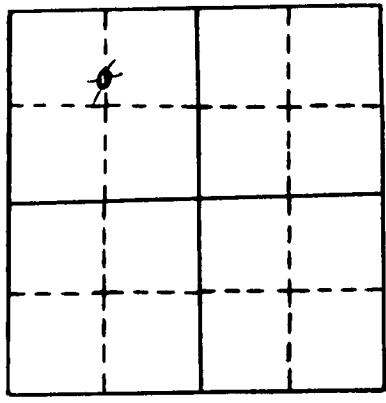

locate well correctly
on above
Section Plot

OIL, GAS OR WATER RECORDS

CASING RECORD

FORMATION	CONTENT	FROM	TO	SIZE	PUT IN	PULLED OUT
Surface Casing	common	0'	247'	8 5/8"	247'	0'

Describe in detail the manner in which the well was plugged, indicating where the mud fluid was placed and the method or methods used in introducing it into the hold. If cement or other plugs were used, state the character of same and depth placed, from _____ feet to _____ feet for each plug set.

Plug #1 1750' with 20sxs

Plug #2 900' with 100sxs

Plug #3 250' with 40sxs

Plug #4 40' with 10sxs
10sxs in rathole

P.D. @ 6:00 P.M. 8-22-83

RECEIVED
STATE CORPORATION COMMISSION

09-19-83 SEP 19 1983

CONSERVATION DIVISION
Wichita, Kansas


(If additional description is necessary, use BACK of this sheet)

Name of Plugging Contractor Pioneer Drilling Company
308 West Mill Plainville, Ks 67663

STATE OF KANSAS COUNTY OF PHILLIPS, ss.

LOWELL F. HAHN (employee of owner) or (owner or operator) of the above described well, being first duly sworn on oath, says: That I have knowledge of the facts, statements, and matters herein contained and the log of the above described well is filed and that the same are true and correct. So help me God.

(Signature) [Signature]
(Address) 353 F Street, Phillipsburg KS

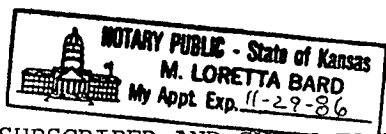

SUBSCRIBED AND SWORN TO before me this 16th day of September, 1983

My commission expires 11-29-86
M. Loretta Bard
Notary Public