

15-065-02514-0000


STATE OF KANSAS  
STATE CORPORATION COMMISSION

WELL PLUGGING RECORD

Give All Information Completely  
Make Required Affidavit  
Mail or Deliver Report to:  
Conservation Division  
State Corporation Commission  
800 Blitting Building  
Wichita, Kansas

Graham County. Sec. 10 Twp. 10S Rge. (E) 21 (W)  
Location as "NE/CNW $\frac{1}{4}$ SW $\frac{1}{4}$ " or footage from lines 900' NE L. & 300' SW L., S $\frac{1}{4}$   
Lease Owner Gulf Oil Corporation  
Lease Name J. Bartos Well No. 1  
Office Address Box 661, Tulsa 2, Oklahoma  
Character of Well (completed as Oil, Gas or Dry Hole) Dry Hole  
Date well completed..... 19.....  
Application for plugging filed..... October 25..... 19 51  
Application for plugging approved..... October 25..... 19 51  
Plugging commenced..... October 25..... 19 51  
Plugging completed..... October 26..... 19 51  
Reason for abandonment of well or producing formation..... Dry Hole

NORTH

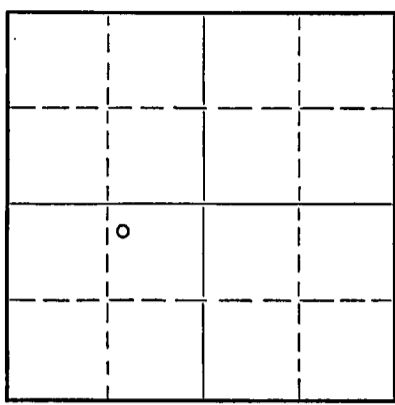

Locate well correctly on above  
Section Plat

If a producing well is abandoned, date of last production..... 19.....  
Was permission obtained from the Conservation Division or its agents before plugging was commenced? Yes

Name of Conservation Agent who supervised plugging of this well..... Mr. Eldon Petty  
Producing formation..... Arbuckle..... Depth to top 3825'..... Bottom..... Total Depth of Well..... 3860 Feet  
Show depth and thickness of all water, oil and gas formations.

OIL, GAS OR WATER RECORDS

CASING RECORD

| Formation | Content | From | To | Size   | Put In | Pulled Out |
|-----------|---------|------|----|--------|--------|------------|
|           |         |      |    | 8-5/8" | 204'   | None       |
|           |         |      |    |        |        |            |
|           |         |      |    |        |        |            |
Describe in detail the manner in which the well was plugged, indicating where the mud fluid was placed and the method or methods used in introducing it into the hole. If cement or other plugs were used, state the character of same and depth placed, from.....feet to.....feet for each plug set.

Hole filled w/heavy mud to 180', bridged w/HONCO plug & 15 sx. cement spotted by HONCO, thru DP, at 180', hole filled w/mud to 35' & capped w/10 sx. cement.

RECEIVED  
STATE CORPORATION COMMISSION  
OCT 31 1951  
CONSERVATION DIVISION  
Wichita, Kansas

(If additional description is necessary, use BACK of this sheet)  
Correspondence regarding this well should be addressed to..... Mr. S. G. Sanderson  
Address..... Box 661, Tulsa Oklahoma

STATE OF Kansas, COUNTY OF Rice, ss.  
Mr. H. H. Wright (employee of owner) of the above-described well,  
being first duly sworn on oath, says: That I have knowledge of the facts, statements, and matters herein contained and the log of the above-described well as filed and that the same are true and correct. So help me God.

(Signature) H. H. Wright  
Box 544, Chase, Kansas  
(Address)

SUBSCRIBED AND SWORN to before me this 30th day of October, 1951  
Sam Council  
Notary Public.

My commission expires April 14, 1952

28-5001-s 8-50-10M

PLUGGING  
FILE SEC 10 10 204  
BOX 661 TULSA OK 5

**WELL RECORD**

GULF 7 889-A PRINTED IN U.S.A.

15-065-02514-0000

WELL NO. 1 LEASE James Bartos COMPANY Gulf Oil Corporation A.F.E. 2727

DATE—DRILLING BEGAN 10-6-51 <sup>Plugging</sup> WELL COMPLETED 10-26-51 FIRST PRODUCTION - -

SAND RECORD Arbuckle 3825' TOTAL DEPTH 3860'

INITIAL PRODUCTION Dry Hole. Plugged and Abandoned

**CASING RECORD**

S- 10 T- 10S R- 21W

| SIZE   | WEIGHT | THD. | CLASS | MAKE | SET AT DEPTH | SACKS CEMENT | LBS. CAL. CHLO. | PULLED | LEFT IN |
|--------|--------|------|-------|------|--------------|--------------|-----------------|--------|---------|
| 8-5/8" | 32     | 10V  | C     | LW   | 204'         | 100          |                 |        | 204'    |

|  |  |  |  |  |  |  |  |  |        |
|--|--|--|--|--|--|--|--|--|--------|
|  |  |  |  |  |  |  |  |  |        |
|  |  |  |  |  |  |  |  |  | C-     |
|  |  |  |  |  |  |  |  |  | NW     |
|  |  |  |  |  |  |  |  |  | NE     |
|  |  |  |  |  |  |  |  |  | SW     |
|  |  |  |  |  |  |  |  |  | q      |
|  |  |  |  |  |  |  |  |  | Graham |
|  |  |  |  |  |  |  |  |  | County |
|  |  |  |  |  |  |  |  |  | Kansas |

ELEVATION— 2232'

**FORMATION RECORD:**

|                | From | To   |              | From  | To    |
|----------------|------|------|--------------|-------|-------|
| Rock & shale   | 0'   | 40'  | Lime         | 3520' | 3555' |
| Shale          |      | 206  | Lime         |       | 3605  |
| Shale          |      | 219  | Lime         |       | 3645  |
| Shale          |      | 500  | Lime         |       | 3675  |
| Shale & shells |      | 825  | Lime         |       | 3710  |
| Sand           |      | 940  | Lime & shale |       | 3755  |
| Shale & shells |      | 1225 | Shale & lime |       | 3795  |
| Shale & shells |      | 1625 | Shale & lime |       | 3832  |
| Shale & shells |      | 1738 | Lime & shale |       | 3845  |
| Anhydrite      |      | 1770 | Lime & shale |       | 3860  |
| Shale & shells |      | 1800 |              |       |       |
| Shale & shells |      | 1955 | TOTAL DEPTH  |       |       |
| Shale & shells |      | 2120 |              |       |       |
| Shale & shells |      | 2200 |              |       |       |
| Shale & shells |      | 2260 |              |       |       |
| Shale & shells |      | 2300 |              |       |       |
| Shale & shells |      | 2350 |              |       |       |
| Lime & shale   |      | 2360 |              |       |       |
| Lime & shale   |      | 2430 |              |       |       |
| Lime & shale   |      | 2570 |              |       |       |
| Lime & shale   |      | 2660 |              |       |       |
| Shale & lime   |      | 2775 |              |       |       |
| Shale & lime   |      | 2790 |              |       |       |
| Lime & shale   |      | 2865 |              |       |       |
| Lime & shale   |      | 2965 |              |       |       |
| Lime & shale   |      | 3065 |              |       |       |
| Lime & shale   |      | 3145 |              |       |       |
| Lime & shale   |      | 3230 |              |       |       |
| Lime & shale   |      | 3330 |              |       |       |
| Lime & shale   |      | 3390 |              |       |       |
| Lime & shale   |      | 3435 |              |       |       |
| Lime & shale   |      | 3486 |              |       |       |
| Lime & shale   |      | 3520 |              |       |       |

ED:RL

12-27-51

**PLUGGING**  
 FILE SEC 10 T 10 R 21W  
 BOOK PAGE 121 LINE 5