


WELL PLUGGING RECORD

Give All Information Completely  
Make Required Affidavit  
Mail or Deliver Report to:  
Conservation Division  
State Corporation Commission  
800 Bitting Building  
Wichita, Kansas

Graham County, Sec. 12 Twp. 10S Rge. 21 (E) W (W)  
Location as "NE/CNW $\frac{1}{4}$ SW $\frac{1}{4}$ " or footage from lines NE $\frac{1}{4}$  NE $\frac{1}{4}$  SE $\frac{1}{4}$   
Lease Owner G-G DRILLING CO. Inc.  
Lease Name Hunt-Behrens Well No. I  
Office Address 206 Union Natl Bank Bldg.  
Character of Well (completed as Oil, Gas or Dry Hole) dry hole  
Date well completed May 6, 19 49  
Application for plugging filed May 6, 19 49  
Application for plugging approved May 6, 19 49  
Plugging commenced May 6, 19 49  
Plugging completed May 6, 19 49  
Reason for abandonment of well or producing formation No oil in known producing formations. Well running structurally low.  
If a producing well is abandoned, date of last production -- 19  
Was permission obtained from the Conservation Division or its agents before plugging was commenced? Yes

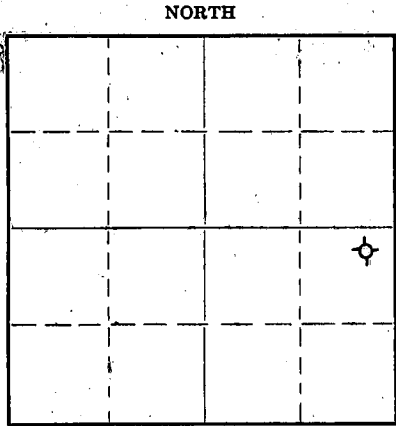

Locate well correctly on above Section Flat

Name of Conservation Agent who supervised plugging of this well Stough  
Producing formation Depth to top Bottom Total Depth of Well Feet  
Show depth and thickness of all water, oil and gas formations.

OIL, GAS OR WATER RECORDS

CASING RECORD

| Formation | Content | From | To | Size   | Put In  | Pulled Out |
|-----------|---------|------|----|--------|---------|------------|
|           |         |      |    | 8-5/8" | 261.27' | --         |
|           |         |      |    |        |         |            |
|           |         |      |    |        |         |            |
|           |         |      |    |        |         |            |
|           |         |      |    |        |         |            |

Describe in detail the manner in which the well was plugged, indicating where the mud fluid was placed and the method or methods used in introducing it into the hole. If cement or other plugs were used, state the character of same and depth placed, from feet to feet for each plug set.

Filled with drilling mud to 263'. Drove plug to 261'. Put in 15 sacks cement then pumped full of mud 25' from top of hole. Drove plug down to 25' then filled to top with 10 sacks of cement.

RECEIVED  
MAY 10 1949  
STATE CORPORATION COMMISSION  
KANSAS

(If additional description is necessary, use BACK of this sheet)

Correspondence regarding this well should be addressed to G-G DRILLING COMPANY, Inc.  
Address 206 Union Natl Bank Bldg., Wichita, Kansas

STATE OF Kansas COUNTY OF Sedgwick ss.  
R. A. Cook (owner or operator) of the above-described well,  
being first duly sworn on oath, says: That I have knowledge of the facts, statements, and matters herein contained and the log of the above-described well as filed and that the same are true and correct. So help me God.

G-G DRILLING CO. Inc.  
(Signature) By President R. A. Cook  
(Address)

SUBSCRIBED AND SWORN TO before me this 6th day of May 19 49

My commission expires June 25, 1951

Wicky Fitz  
Notary Public.

PLUGGING  
FILE SEC 12 T 10 R 21 W  
BOOK PAGE 95 LINE 22

CONTRACTOR'S WELL LOG

Operator C-G Drilling Co. Inc. Farm Name Hunt-Behrens Well No. I  
 Location C NE $\frac{1}{4}$  NE $\frac{1}{4}$  SE $\frac{1}{4}$   
 Pool Name Wildcat County Graham State Kansas  
 Commencement Date April 20, 1949 Completion Date May 6, 1949

LOG OF WELL

Elevation 2089' DF  
 All measurements <sup>etc</sup> from the top of rotary bushing.

| DEPTH |      | FORMATION         | DEVIATION FROM VERTICAL | REMARKS: |
|-------|------|-------------------|-------------------------|----------|
| FROM  | TO   |                   |                         |          |
| 40    | 260  | Sand-Shale        |                         |          |
| 260   | 700  | Shale-Shells      |                         |          |
| 700   | 1150 | Shale-Shells      |                         |          |
| 1150  | 1595 | Shale-Sand-Redbed | 1500' - 0°              |          |
| 1595  | 1695 | Red Bed-Shale     |                         |          |
| 1695  | 1735 | Anhydrite         |                         |          |
| 1735  | 1770 | Shale-Shells      |                         |          |
| 1770  | 2070 | Shale-Shells      |                         |          |
| 2070  | 2145 | Shale-Shells      | 2000' - 0°              |          |
| 2145  | 2265 | Shale-Lime        |                         |          |
| 2265  | 2380 | Shale-Lime        |                         |          |
| 2380  | 2455 | Shale-Lime        |                         |          |
| 2455  | 2555 | Lime-Shale        | 2500' - 0°              |          |
| 2555  | 2615 | Shale-Lime        |                         |          |
| 2615  | 2700 | Lime-Shale        |                         |          |
| 2700  | 2770 | Lime-Shale        |                         |          |
| 2770  | 2835 | Lime-Shale        |                         |          |
| 2835  | 2935 | Shale-Lime        |                         |          |
| 2935  | 3025 | Lime-Shale        |                         |          |
| 3025  | 3115 | Shale-Lime        |                         |          |
| 3115  | 3210 | Shale-Lime        |                         |          |
| 3210  | 3275 | Lime-Shale        | 3200' - 0°              |          |
| 3275  | 3350 | Lime-Shale        |                         |          |
| 3350  | 3425 | Lime-Shale        |                         |          |
| 3425  | 3470 | Lime              |                         |          |
| 3470  | 3500 | Lime              |                         |          |
| 3500  | 3539 | Lime              |                         |          |
| 3539  | 3565 | Lime              |                         |          |
| 3565  | 3580 | Lime              |                         |          |
| 3580  | 3635 | Lime-Shale        |                         |          |
| 3635  | 3685 | Lime-Shale        |                         |          |
| 3685  | 3740 | Lime              |                         |          |
| 3740  | 3785 | Lime              |                         |          |
| 3785  | 3845 | Lime              |                         |          |
| 3845  | 3892 | Lime              |                         |          |

CASING LEFT IN HOLE AFTER COMPLETION  
 261.27' (12 jts.) 8-5/8" OD surface casing.

STATE OF KANSAS, COUNTY OF SEDGWICK, ) ss.

The undersigned certifies that to the best of his knowledge and belief the above facts are true and correct.

C-G DRILLING COMPANY, Inc.

By R. A. Cook, President

Subscribed and sworn to before me this 6th day of May, 1949.

Wicky Fritz  
 Notary Public

My commission expires:  
 June 25, 1951

