


STATE OF KANSAS
STATE CORPORATION COMMISSION
Give All Information Completely
Make Required Affidavit
Mail or Deliver Report to:
Conservation Division
State Corporation Commission
211 No. Broadway
Wichita, Kansas

WELL PLUGGING RECORD

Graham County. Sec. 12 Twp. 10 Rge. 21 (E) W (W)
Location as "NE/CNW/SW" or footage from lines SE SW SE
Lease Owner C-G DRILLING CO.
Lease Name Hunt-Behrens Well No. 3
Office Address 107 Rule Building
Character of Well (completed as Oil, Gas or Dry Hole) oil well
Date well completed June 3 19 55
Application for plugging filed 8/22/62 19
Application for plugging approved 8/23/62 19
Plugging commenced 9/6/62 19
Plugging completed 9/6/62 19
Reason for abandonment of well or producing formation No longer commercial

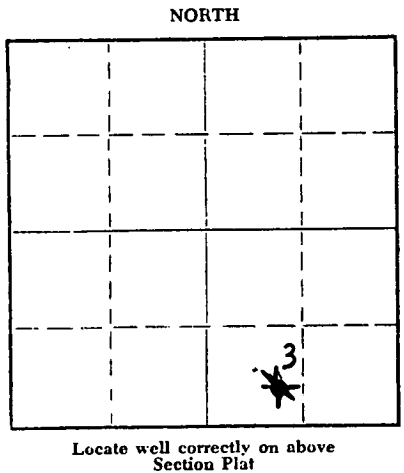

If a producing well is abandoned, date of last production 1/2/59 19
Was permission obtained from the Conservation Division or its agents before plugging was commenced? yes

Name of Conservation Agent who supervised plugging of this well Eldon Petty
Producing formation Arbuckle Depth to top 3837 Bottom 3856 Total Depth of Well 3856 Feet
Show depth and thickness of all water, oil and gas formations.

OIL, GAS OR WATER RECORDS				CASING RECORD		
FORMATION	CONTENT	FROM	TO	SIZE	PUT IN	PULLED OUT
				8-5/8"	169.91	none
				5-1/2"	3849.96	none

Describe in detail the manner in which the well was plugged, indicating where the mud fluid was placed and the method or methods used in introducing it into the hole. If cement or other plugs were used, state the character of same and depth placed, from feet to feet for each plug set.
Filled with heavy mud to 1756'; set plug at 1756, filled to top of hole with 70 sacks of cement.

RECEIVED
STATE CORPORATION COMMISSION
SEP 25 1962 09-25-62
CONSERVATION DIVISION
Wichita, Kansas

(If additional description is necessary, use BACK of this sheet)

Name of Plugging Contractor Globe Cementing Co.
Address Great Bend, Kansas, P. O. Box 628

STATE OF Kansas, COUNTY OF Sedgwick, ss.
Jay H. Galloway ~~XXXXXX~~ or (owner or operator) of the above-described well, being first duly sworn on oath, says: That I have knowledge of the facts, statements, and matters herein contained and the log of the above-described well as filed and that the same are true and correct. So help me God.
(Signature) Jay H. Galloway
107 Rule Building, Wichita, Kansas
(Address)

SUBSCRIBED AND SWORN TO before me this 11 day of September, 19 62
Vicky Jacobs
My commission expires May 20, 1963
Notary Public.

CONTRACTOR'S WELL LOG

15-065-00768-0000

OPERATOR C-G Drilling Co. & D. G. Hansen WELL NAME Hunt-Behrens #3
 LOCATION SE SW SE Sec. 12-10-21W.
 POOL NAME _____ COUNTY Graham STATE Kansas
 COMMENCEMENT DATE May 25, 1955 COMPLETION DATE June 3, 1955

LOG OF WELL

Elevation 2269'R.B.

All measurements from the top of rotary bushing.

FROM	TO	FORMATION	DEVIATION FROM VERTICAL	REMARKS:
0	170	Shale-Sand		
170	870	Shale		
870	970	Sand		
970	1160	Shale-Sand		
1160	1240	Sand-Shale		
1240	1530	Sand		
1530	1748	Red Bed		
1748	1790	Anhydrite		
1790	1870	Shale		
1870	2270	Shale-Shells		
2270	2400	Lime-Shale		
2400	2520	Lime-Shale	0° - 2500'	
2520	2610	Lime-Shale		
2610	2720	Lime-Shale		
2720	2850	Lime-Shale		
2850	2970	Lime-Shale		
2970	3080	Lime-Shale	0° - 3000'	
3080	3200	Lime-Shale		
3200	3275	Lime-Shale		
3275	3360	Lime-Shale		
3360	3440	Lime-Shale		
3440	3510	Lime-Shale		
3510	3564	Lime-Shale	0° - 3500'	
3564	3620	Lime-Shale		
3620	3685	Lime-Shale		
3685	3733	Lime-Shale		
3733	3783	Lime-Shale	0° - 3750'	
3783	3840	Lime-Shale		
3840	3856	Lime		DST 3839-56'.

RECEIVED
 STATE CONSERVATION COMMISSION
 AUG 2 1962
 CONSERVATION DIVISION
 Wichita, Kansas

CASING LEFT IN HOLE AFTER COMPLETION

Set 169.91' (8 jts.) 8-5/8" Surface Casing with 150 sacks cement.

Ran 3849.96' (119 jts.) 5-1/2" OD Casing.

STATE OF KANSAS, COUNTY OF SEDGWICK) ss.

The undersigned certifies that to the best of his knowledge and belief, the above facts are true and correct.

C-G DRILLING CO.

By Jay H. Galloway
 Jay H. Galloway

Subscribed and sworn to before me this 9th day of June, 1955.

My commission expires: June 25, 1955

Victor L. Galloway
 Notary Public