


STATE OF KANSAS
STATE CORPORATION COMMISSION

Form CP-4

Give All Information Completely
Make Required Affidavit
Mail or Deliver Report to:
Conservation Division
State Corporation Commission
212 No. Market
Wichita, Kansas 67202

WELL PLUGGING RECORD

NORTH

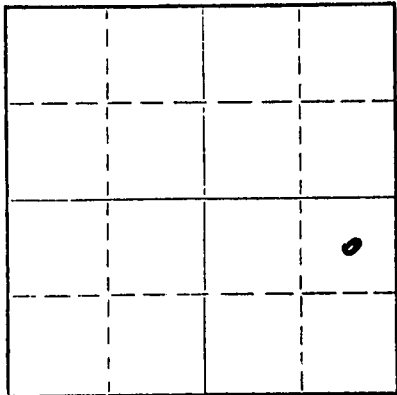

Locate well correctly on above
Section Plat

Graham County, Sec. 12 Twp. 10S Rge. (E) 21 (W)
Location as "NE/CNW/SW" or footage from lines NE SE SE
Lease Owner Leben Drilling, Inc.
Lease Name Beiker Well No. 5
Office Address P.O. Box 486 Great Bend, Kansas 67530
Character of Well (completed as Oil, Gas or Dry Hole) oil
Date well completed December 14 1964
Application for plugging filed September 15 1970
Application for plugging approved September 16 1970
Plugging commenced September 22 1970
Plugging completed September 22 1970
Reason for abandonment of well or producing formation Depleted

If a producing well is abandoned, date of last production December 1970
Was permission obtained from the Conservation Division or its agents before plugging was commenced? yes

Name of Conservation Agent who supervised plugging of this well W. L. Nichols
Producing formation Arbuckle Depth to top 3813' Bottom 3824' Total Depth of Well 3824' Feet
Show depth and thickness of all water, oil and gas formations.

OIL, GAS OR WATER RECORDS

CASING RECORD

FORMATION	CONTENT	FROM	TO	SIZE	PUT IN	PULLED OUT
				5 1/2"	3814'	None
				8 5/8	181'	None

Describe in detail the manner in which the well was plugged, indicating where the mud fluid was placed and the method or methods used in introducing it into the hole. If cement or other plugs were used, state the character of same and depth placed, from feet to feet for each plug set.

12 Sxs. 50/50 Pozmix w/6% Gel from 3550' to 3370'
25 sxs. Gel from 3370' to 900'
80 sxs. 50/50 Pozmix w/6% Gel from 900' to surface

400 psi max., 150 psi standing pressure.

All work done by Sun Oilwell Cementing, Inc. - Pump truck

RECEIVED
STATE CORPORATION COMMISSION
SEP 25 1970
CONSERVATION DIVISION
Wichita, Kansas

IN ADDITION
PLEASE NOTE AGENTS FIELD REPORT

(If additional description is necessary, use BACK of this sheet)

Name of Plugging Contractor Leben Drilling, Inc.
Address P.O. Box 486 Great Bend, Kansas 67530

STATE OF Kansas, COUNTY OF Barton, ss.

A. J. Nelson (employee of owner) or (owner or operator) of the above-described well, being first duly sworn on oath, says: That I have knowledge of the facts, statements, and matters herein contained and the log of the above-described well as filed and that the same are true and correct. So help me God.

(Signature) A. J. Nelson

P.O. Box 486 Great Bend, Kansas
(Address)

Subscribed and Sworn to before me this 23rd day of September, 1970

Helen L. Lindermuth

Notary Public.

November 13, 1973

