


STATE OF KANSAS
STATE CORPORATION COMMISSION
Give All Information Completely
Make Required Affidavit
Mail or Deliver Report to:
Conservation Division
State Corporation Commission
211 No. Broadway
Wichita, Kansas

WELL PLUGGING RECORD

Graham County, Sec. 12 Twp. 10 Rge. 21 (E) W (W)
Location as "NE/CNWxSWx" or footage from lines SW NE SE
Lease Owner C-G Drilling Co.
Lease Name Hunt-Behrens Well No. 6
Office Address 107 Rule Building, Wichita, Kansas
Character of Well (completed as Oil, Gas or Dry Hole) oil well
Date well completed March 7, 1956
Application for plugging filed August 22, 1962
Application for plugging approved August 23, 1962
Plugging commenced September 6, 1962
Plugging completed September 6, 1962
Reason for abandonment of well or producing formation no longer commercial

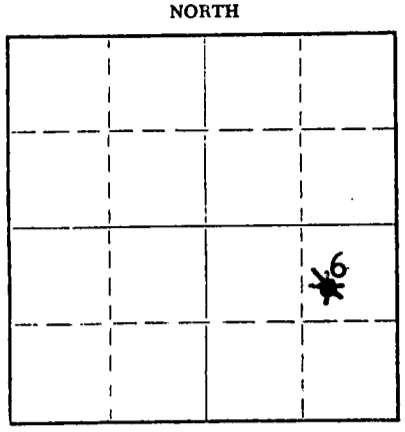

If a producing well is abandoned, date of last production September, 1961
Was permission obtained from the Conservation Division or its agents before plugging was commenced? Yes

Name of Conservation Agent who supervised plugging of this well Eldon Petty
Producing formation Arbuckle Depth to top 3795 Bottom 3805 Total Depth of Well 3805 Feet
Show depth and thickness of all water, oil and gas formations.

OIL, GAS OR WATER RECORDS				CASING RECORD		
FORMATION	CONTENT	FROM	TO	SIZE	PUT IN	PULLED OUT
				8-5/8"	180.76'	none
				5-1/2"	3797'	none

Describe in detail the manner in which the well was plugged, indicating where the mud fluid was placed and the method or methods used in introducing it into the hole. If cement or other plugs were used, state the character of same and depth placed, from _____ feet to _____ feet for each plug set.

Filled with heavy mud to 2940'. Set plug and filled to top of hole with cement.

RECEIVED
STATE CORPORATION COMMISSION
SEP 25 1962 09-25-62
CONSERVATION DIVISION
Wichita, Kansas

(If additional description is necessary, use BACK of this sheet)
Name of Plugging Contractor Globe Cementing Co.
Address P. O. Box 628, Great Bend, Kansas

STATE OF KANSAS, COUNTY OF Sedgwick, ss.
Jay H. Galloway (owner or operator) of the above-described well, being first duly sworn on oath, says: That I have knowledge of the facts, statements, and matters herein contained and the log of the above-described well as filed and that the same are true and correct. So help me God.
(Signature) Jay H. Galloway Jay H. Galloway
107 Rule Building, Wichita, Kansas
(Address)

SUBSCRIBED AND SWORN TO before me this 11th day of September 19 62

My commission expires May 20, 1963
Vicky Jacobs
Vicky Jacobs Notary Public.

15-065-03034-0000

CONTRACTOR'S WELL LOG

OPERATOR C-G Drilling Co. & D. G. Hansen WELL NAME Hunt-Behrens #6
LOCATION SW NE SE SEC. 12-108-21W RIG NO. 1
COUNTY Graham STATE Kansas
COMMENCEMENT DATE February 27, 1956 COMPLETION DATE March 7, 1956

LOG OF WELL

Elevation 2224' rotary bushing.
All measurements taken from the top of rotary bushing.

FROM	TO	FORMATION	DEVIATION FROM VERTICAL	REMARKS:
0	600	Shale		
600	1210	Shale-Sand		
1210	1450	Sand	3795'	
1450	1650	Red Bed	2224'	
1650	1724	Red Bed	571'	
1724	1764	Anhydrite		
1764	2090	Shale-Shell		
2090	3505	Lime-Shale		
3505	3588	Lime		
3588	3805	Lime-Shale		

RECORDED
STATE COMPLETION COMMISSION
AUG 28 1962
CONSERVATION

CASING LEFT IN HOLE AFTER COMPLETION

Ran 180.76' (9 jts.) 8-5/8" OD Surface Casing.
Set 3797' (119 jts.) 5-1/2" OD Casing.

STATE OF KANSAS }
COUNTY OF SEDGWICK } SS.

The undersigned hereby certifies that to the best of his knowledge and belief, the above facts are true and correct.

C-G DRILLING CO.

By Jay H. Galloway
Jay H. Galloway

SUBSCRIBED AND SWORN TO BEFORE ME THIS 7th day of March, 1956.

My Commission expires: May 20, 1959

Vicky Jacobs
Vicky Jacobs, Notary Public

