

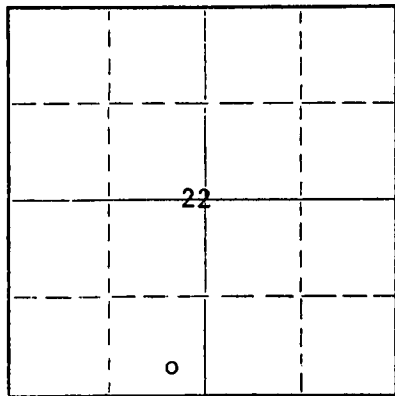
STATE OF KANSAS
STATE CORPORATION COMMISSION

WELL PLUGGING RECORD

Give All Information Completely
Make Required Affidavit
Mail or Deliver Report to:
Conservation Division
State Corporation Commission
212 No. Market
Wichita, Kansas

Graham County, Sec 22 Twp 10S Rge. (X) 21 (W)
Location as "NE/CNW/SW" or footage from lines 50' East S/2 SE SW
Lease Owner A. L. Abercrombie, Inc.
Lease Name Hayes A Well No. 3
Office Address 801 Union Center, Wichita, Kansas 67202
Character of Well (completed as Oil, Gas or Dry Hole) Dry Hole
Date well completed July 16 19 68
Application for plugging filed July 16 Verbally 19 68
Application for plugging approved July 16 Verbally 19 68
Plugging commenced July 16 19 68
Plugging completed July 16 19 68
Reason for abandonment of well or producing formation Dry Hole

NORTH



Locate well correctly on above Section Plat

If a producing well is abandoned, date of last production None 19
Was permission obtained from the Conservation Division or its agents before plugging was commenced? Yes Verbally

Name of Conservation Agent who supervised plugging of this well Leo F. Massey, Hays, Kansas
Producing formation Depth to top Bottom Total Depth of Well 3785 Feet
Show depth and thickness of all water, oil and gas formations.

OIL, GAS OR WATER RECORDS

CASING RECORD

FORMATION	CONTENT	FROM	TO	SIZE	PUT IN	PULLED OUT
				7 5/8"	229'	None

Describe in detail the manner in which the well was plugged, indicating where the mud fluid was placed and the method or methods used in introducing it into the hole. If cement or other plugs were used, state the character of same and depth placed, from feet to feet for each plug set.

1st plug pumped through drill pipe by Sun Cementing and set at 1260' with 75 sacks cement
2nd plug pumped through drill pipe by Sun Cementing and set at 240' with 20 sacks cement
3rd plug set at 40' with 10 sacks cement
Plug down @ 6:30 P.M. 7-16-68

RECEIVED
STATE CORPORATION COMMISSION
JUL 22 1968
CONSERVATION DIVISION
Wichita, Kansas

(If additional description is necessary, use BACK of this sheet)
Name of Plugging Contractor Abercrombie Drilling, Inc.
Address 801 Union Center, Wichita, Kansas 67202

STATE OF Kansas, COUNTY OF Sedgwick, ss.
A. L. Abercrombie (~~employee of owner~~) (owner or operator) of the above-described

well, being first duly sworn on oath, says: That I have knowledge of the facts, statements, and matters herein contained and the log of the above-described well as filed and that the same are true and correct. So help me God.

(Signature) [Signature]
A. L. Abercrombie
801 Union Center, Wichita, Kansas 67202
(Address)

SUBSCRIBED AND SWORN TO before me this 18th day of July, 19 68

My commission expires October 5, 1968
Mildred Saxton Notary Public.

CONTRACTOR'S WELL LOG

OWNER: A. L. Abercrombie, Inc.
 CONTRACTOR: Abercrombie Drilling, Inc.
 LEASE: BEN HAYES #3
 LOCATION: Approx. C S/2 SE SW, Sec. 22-10S-21W
 Graham County, Kansas
 GEOLOGIST: Jack K. Wharton

0	60	Rock
60	110	Sand & Clay
110	155	Shaley Clay
155	750	Shale
750	840	Sand
840	1060	Shale
1060	1350	Sand
1350	1624	Shale
1624	1670	Anhydrite
1670	2200	Shale w/ Lime Streaks
2200	2390	Shale w/ Lime
2390	3415	Lime & Shale
3415	3523	Lime
3523	3590	Lime and Shale
3590	3740	Lime
3740	3743	Shale & Lime
3743	3750	Lime & Shale
3750	3765	Lime
3765	3785	Arbuckle
	3785	Rotary Total Depth

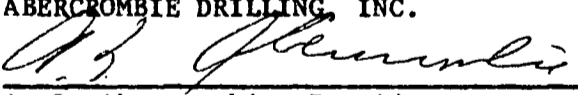
Drilled 239' of 11" surface hole and set 7-5/8" casing @ 229' w/100 sx. cement.
 Plug was down at 6:30 P.M., 7-16-68
 Dry & Abandoned

SAMPLE FORMATION TOPS		ELEVATION	
Anhydrite	1624	(- 537)	2161 K. B.
Heebner	3398	(-1237)	2159 D. F.
Toronto	3421	(-1260)	2153 G. L.
Lansing	3437	(-1276)	
Arbuckle	3752	(-1591)	
R. T. D.	3785	(-1624)	

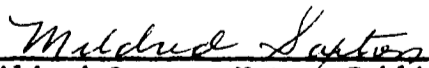
RECEIVED
 STATE CORPORATION COMMISSION
 JUL 25 1968
 CONSERVATION DIVISION
 Wichita, Kansas

STATE OF KANSAS)
) SS
 COUNTY OF SEDGWICK)

A. L. Abercrombie, President of Abercrombie Drilling, Inc., does hereby state that the above is a true and correct copy of the log of the #3 BEN HAYES, Approx. C S/2 SE SW, Sec. 22-10S-21W, Graham County, Kansas.

ABERCROMBIE DRILLING, INC.

 A. L. Abercrombie, President

Subscribed and sworn to before me, a Notary Public, in and for the County of Sedgwick, State of Kansas, as of this 17th day of July, 1968.


 Mildred Saxton, Notary Public

My Commission Expires October 5, 1968.

