


WELL PLUGGING RECORD

Give All Information Completely
Make Required Affidavit
Mail or Deliver Report to:
Conservation Division
State Corporation Commission
800 Bitting Building
Wichita, Kansas

NORTH

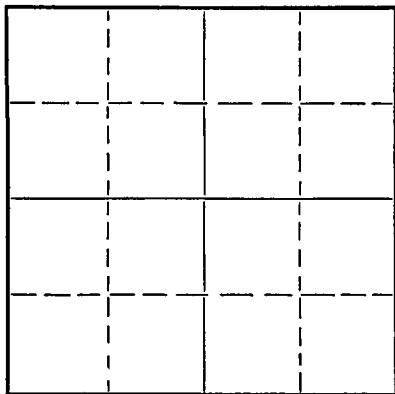

Locate well correctly on above
Section Plat

.....Graham.....County. Sec...22...Twp...10S. Rge..... (E)...21 (W)
Location as "NE/CNW $\frac{1}{4}$ SW $\frac{1}{4}$ " or footage from lines.....SW, SW, NW
Lease Owner.....C. L. Miller Jones, Shelburne, & Farmer, Inc. P.K.C.
Lease Name.....Miller B. Well No. 1
Office Address.....Russell, Kansas
Character of Well (completed as Oil, Gas or Dry Hole).....Dry hole
Date well completed.....3/18.....1951
Application for plugging filed.....3/18.....1951
Application for plugging approved.....3/18.....1951
Plugging commenced.....3/18.....1951
Plugging completed.....3/18.....1951
Reason for abandonment of well or producing formation.....Dry

If a producing well is abandoned, date of last production.....Never produced.....19.....
Was permission obtained from the Conservation Division or its agents before plugging was com-
menced?.....Yes.....

Name of Conservation Agent who supervised plugging of this well.....Mr. Eldon Petty.....
Producing formation..... Depth to top..... Bottom..... Total Depth of Well..... Feet
Show depth and thickness of all water, oil and gas formations.

OIL, GAS OR WATER RECORDS

CASING RECORD

Formation	Content	From	To	Size	Put In	Pulled Out
				8-5/8"	180'	none

Describe in detail the manner in which the well was plugged, indicating where the mud fluid was placed and the method or methods used in introducing it into the hole. If cement or other plugs were used, state the character of same and depth placed, from.....feet to.....feet for each plug set.

- Hole was filled with heavy mud
- Halliburton plug pushed to 170' and 1/2 sack of hulls placed on top of plug.
- 15 sacks of cement mixed and dumped on top of plug.
- Hole filled and second Halliburton plug pushed to 40'
- 1/2 sack of hulls placed on top of second plug and 10 sacks of cement mixed and hole filled to top with same

FILED
STATE CORPORATION COMMISSION
MAR 28 1951
CONSERVATION DIVISION
Wichita, Kansas

(If additional description is necessary, use BACK of this sheet)

Correspondence regarding this well should be addressed to.....Jones, Shelburne & Farmer, Inc.
Address.....Russell, Kansas

STATE OF KANSAS, COUNTY OF RUSSELL, ss.
John O. Farmer (employee of owner) or (owner or operator) of the above-described well,

being first duly sworn on oath, says: That I have knowledge of the facts, statements, and matters herein contained and the log of the above-described well as filed and that the same are true and correct. So help me God.

(Signature) John O. Farmer
(Address)

SUBSCRIBED AND SWORN to before me this 27th day of March, 1951

My commission expires February 19, 1951
Josephine E. Weay Notary Public.

PLUGGING
FILE SEC 22 T 10 R 21 W
BOOK PAGE 68 LINE 9

Jones, Shelburne & Farmer, Inc.

Russell, Kansas

CONTRACTOR'S VERIFIED LOG

Operator JONES, SHELBURNE & FARMER, INC Farm Name Killer B Well No 1

Location SW SW NW 22-10-21

Pool Name Wildcat County Graham State Kansas

Commencement Date _____ Completion Date _____

Log of Well

Depth		Formation	Deviation from vertical (degrees)	Remarks
From	To			
0	155	Lime & Shale		
155	720	Shale & Shells		
720	1405	Shale, Shells & Sand		
1405	1630	Shale & Shells		
1630	1680	Anhydrite		
1680	1800	Shale & Shells		
1800	1970	Shale & Lime		
1970	2310	Shale & Shells		
2310	3420	Lime & Shale		
3420	3680	Lime		
3680	3760	Lime & Shale		
3760	3818	Conglomerate		
3818	3850	Lime		

PLUGGING
 FILE SEC 22 T 10 R 21 W
 BOOK PAGE 62 LINE 9

