

15-065-00885-000

STATE OF KANSAS
STATE CORPORATION COMMISSION

Give All Information Completely
Make Required Affidavit
Mail or Deliver Report to:
Conservation Division
State Corporation Commission
211 No. Broadway
Wichita, Kansas

WELL PLUGGING RECORD

Graham County. Sec. 19 Twp. 10 Rge. 21 (EW (W))

Location as "NE/CNWxSWx" or footage from lines. SE SE SW

Lease Owner Nadel and Gussman

Lease Name Hills Well No. 1

Office Address 1714 First National Building, Tulsa 3, Oklahoma

Character of Well (completed as Oil, Gas or Dry Hole) Dry

Date well completed 9-7-56

Application for plugging filed 9-7-56

Application for plugging approved 9-7-56


Plugging commenced 9-7-56

Plugging completed 9-7-56

Reason for abandonment of well or producing formation Dry

If a producing well is abandoned, date of last production _____ 19____

Was permission obtained from the Conservation Division or its agents before plugging was commenced? Yes

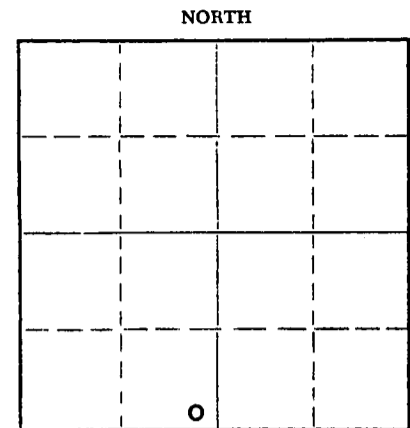

Locate well correctly on above Section Plat

Name of Conservation Agent who supervised plugging of this well Eldon Petty

Producing formation _____ Depth to top _____ Bottom _____ Total Depth of Well 3947 Feet

Show depth and thickness of all water, oil and gas formations.

OIL, GAS OR WATER RECORDS

CASING RECORD

| FORMATION | CONTENT | FROM | TO | SIZE | PUT IN | PULLED OUT |
|-----------|---------|------|----|-------|--------|------------|
| | | | | 8-5/8 | 180 | 0 |
| | | | | | | |
| | | | | | | |
Describe in detail the manner in which the well was plugged, indicating where the mud fluid was placed and the method or methods used in introducing it into the hole. If cement or other plugs were used, state the character of same and depth placed, from _____ feet to _____ feet for each plug set.

Filled hole with heavy mud from 3947 to 170' - set plug and cemented with 15 sacks cement. Set second plug at 40' and cemented 10 sacks cement.

(If additional description is necessary, use BACK of this sheet)

Name of Plugging Contractor Reserve Drilling Company, Inc.

Address Wichita 2, Kansas

STATE OF KANSAS, COUNTY OF SEDGWICK, ss.

(employee of owner) XXXXXXXXXXXX of the above-described well, being first duly sworn on oath, says: That I have knowledge of the facts, statements, and matters herein contained and the log of the above-described well as filed and that the same are true and correct. So help me God.

(Signature) L.C. Hay
Wichita 2, Kansas
(Address)

SUBSCRIBED AND SWORN TO before me this 11th day of September, 1956

My commission expires Nov. 3, 1956

Notary Public.

PLUGGING
FILE SEC. 19 T. 10 R. 21W
BOOK PAGE 97 LINE 30

RECEIVED
SEP 14 1956
CONSERVATION DIVISION
Wichita, Kansas
09-14-56

WELL LOG

Nedel and Gussman
Comm: 8-28-56
Comp: 9-7-56

HILLS No. 1

SE SE SW 19-10-21W
Graham County, Kansas

Casing: 8-5/8" 180' v/100 sax

| <u>Formations</u> | <u>Depth</u> |
|------------------------|--------------|
| Clan and post rock | 60 |
| Shale | 185 |
| Shale and shells | 660 |
| Sand | 675 |
| Red bed and shale sand | 1400 |
| Shale and shells | 1715 |
| Anhydrite | 1763 |
| Shale and shells | 2220 |
| Shale and lime | 2345 |
| Shale and shells | 2410 |
| Lime and shale | 2580 |
| Lime | 2780 |
| Shale and lime | 3290 |
| Lime | 2931 |
| Arbuckle | 3947 |

STATE OF KANSAS)
) SS:
COUNTY OF SEDGWICK)

L. C. Hay, of lawful age, states that the above depths and formations are correct to his best knowledge.

L. C. Hay

Subscribed and sworn to before me this 11th day of September, 1956.

W. C. Bandy
Notary Public

My commission expires Nov. 3, 1956

| | | | |
|----------|---------|-------|--------|
| PLUGGING | | | |
| FILE | SEC. 19 | T. 10 | R. 21W |
| BOOK | PAGE 97 | LINE | 30 |