


STATE OF KANSAS  
STATE CORPORATION COMMISSION

WELL PLUGGING RECORD

Give All Information Completely  
Make Required Affidavit  
Mail or Deliver Report to:  
Conservation Division  
State Corporation Commission  
800 Bittling Building  
Wichita, Kansas

Graham County, Sec. 12 Twp. 10S Rge. 21 (E) W (W)  
Location as "NE/CNWxSWx" or footage from lines SE NW NE  
Lease Owner D. G. Hansen  
Lease Name Bass "B" Well No. I  
Office Address Logan, Kansas  
Character of Well (completed as Oil, Gas or Dry Hole) dry hole  
Date well completed April 10 19 55  
Application for plugging filed April 10 19 55  
Application for plugging approved April 10 19 55  
Plugging commenced April 10 19 55  
Plugging completed April 10 19 55  
Reason for abandonment of well or producing formation Too low structurally

NORTH

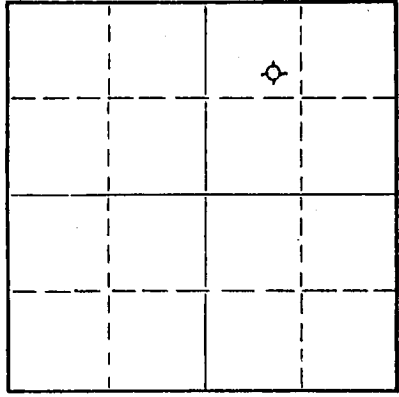

Locate well correctly on above  
Section Plat

If a producing well is abandoned, date of last production 19  
Was permission obtained from the Conservation Division or its agents before plugging was commenced? Yes

Name of Conservation Agent who supervised plugging of this well Eldon Petty, Hays, Kansas  
Producing formation Depth to top Bottom Total Depth of Well Feet  
Show depth and thickness of all water, oil and gas formations.

OIL, GAS OR WATER RECORDS

CASING RECORD

FORMATION	CONTENT	FROM	TO	SIZE	PUT IN	PULLED OUT
				8-5/8"	167.28'	none

Describe in detail the manner in which the well was plugged, indicating where the mud fluid was placed and the method or methods used in introducing it into the hole. If cement or other plugs were used, state the character of same and depth placed, from feet to feet for each plug set.

Filled hole with drilling mud to 160'; set plug; put in 1/2 sack hulls, 15 sacks cement. Filled with drilling mud to 40'; set plug than filled hole to top with 1/2 sack hulls and 10 sacks cement.

(If additional description is necessary, use BACK of this sheet)

Name of Plugging Contractor C-G DRILLING CO.  
Address 107 Rule Building, Wichita, Kansas

STATE OF KANSAS, COUNTY OF SEDGWICK, ss.  
Jay H. Galloway (employee of owner) or (owner or operator) of the above-described well, being first duly sworn on oath, says: That I have knowledge of the facts, statements, and matters herein contained and the log of the above-described well as filed and that the same are true and correct. So help me God.

(Signature) Jay H. Galloway  
107 Rule Building, Wichita, Kansas  
(Address)

SUBSCRIBED AND SWORN TO before me this 14th day of April, 19 55

My commission expires June 25, 1955

Notary Public.  
STATE CORP  
DIVISION

APR 15 1955 04-15-55

**PLUGGING**  
FILE SEC 12 T 10 R 21  
BOOK PAGE 110 LINE 42

CONSERVATION DIVISION  
Wichita, Kansas

CONTRACTOR'S WELL LOG

OPERATOR D. G. Hansen FARM NAME Bass "B" #I  
LOCATION SE/4 NW/4 NE/4 Sec. 12-10-21West  
POOL NAME Cooper COUNTY Graham STATE Kansas  
COMMENCEMENT DATE MARCH 31, 1955 COMPLETION DATE April 10, 1955

LOG OF WELL

Elevation 2203' R.B.  
ALL measurements from the top of rotary bushing.

FROM	TO	FORMATION	DEVIATION FROM VERTICAL	REMARKS:
0	167	Shale		
167	425	Shale-Shells		
425	820	Shale-Sand		
820	920	Sand		
920	1235	Shale		
1235	1440	Sand-Sandy Shale		
1440	1683	Red Bed-Shale	0° - 1500'	
1683	1721	Anhydrite		
1721	1910	Shale-Shells	0	
1910	2200	Lime-Shale	0° - 2000'	
2200	2400	Lime-Shale		
2400	2560	Lime-Shale	0° - 2500'	
2560	2700	Lime-Shale		
2700	2850	Lime-Shale		
2850	2905	Lime-Shale		
2905	3010	Lime-Shale	0° - 3000'	
3010	3120	Lime-Shale		
3120	3220	Lime-Shale		
3220	3275	Lime-Shale		
3275	3345	Lime-Shale		
3345	3406	Lime-Shale		
3406	3448	Lime-Shale		
3448	3465	Lime-Shale	0	
3465	3530	Lime-Shale	0° - 3500'	
3530	3579	Lime		
3579	3618	Lime		
3618	3680	Lime-Shale		
3680	3730	Lime-Shale		
3730	3774	Lime-Shale		
3774	3787	Lime-Shale		DST 3778-82'
3787	3797	Lime		DST 3787-92'
3797	3808	Lime-Shale		

CASING LEFT IN HOLE AFTER COMPLETION

Ran 8 jts. (167.28') 8-5/8" OD Surface Casing, 24#.

STATE OF KANSAS, COUNTY OF SEDGWICK ) ss.

The undersigned certifies that to the best of his knowledge and belief, the above facts are true and correct.

C-G DRILLING CO.

By Jay H. Galloway  
Jay H. Galloway

Subscribed and sworn to before me this 14th day of April, 1955.

My commission expires June 25, 1955

Vicky Fritz  
Notary Public

**PLUGGING**  
FILE SEC 12 T 10 R 21 W  
BOOK PAGE 110 LINE 42